

APPROXIMATE BID QUANTITIES

ITEM	DESCRIPTION	QUANTITY	UNIT
1	CONSTRUCT 8" PVC SANITARY SEWER PIPE	9,425 9,699	LF
2	CONSTRUCT 6" PVC SANITARY SEWER PIPE	5,440 5,020	LF
3	CONSTRUCT 54" I.D. SANITARY MAHOLE (48)	630	VF
4	TAP EXISTING MANHOLE	2	EA
5	CONNECT TO EXISTING SANITARY SEWER	2	EA
6	CONSTRUCT CONCRETE MANHOLE RING RETAINER	0 3	EA
7	CONSTRUCT 8" DIAMETER DROP CONNECTION (3)	22	VF
8	CONSTRUCT 6" PVC SANITARY SEWER SERVICE RISER	68	VF
9	REMOVE 8" SANITARY SEWER PIPE	20	LF
10	ADJUST MANHOLE TO GRADE	35.5 38	VF
EXTRAS			
A	CONSTRUCT SADDLE WYE CONNECTION	2	EA
B	REPAIR DAMAGED MANHOLE	1	EA
C	ADDITIONAL AIR TESTING REQD. BY ENGINEER	1	LS
D	ADDITIONAL MOBILIZATION	1	LS


INDEX OF SHEETS

SHEET No.	DESCRIPTION
1	COVER
2	NOTES
3	DETAILS
4	GREENLEAF STREET SANITARY SEWER PLAN & PROFILE
5	185TH & GREENLEAF STREET SANITARY SEWER PLAN & PROFILE
6	SOUTH 183rd STREET SANITARY SEWER PLAN & PROFILE
7	BIRCH AVENUE SANITARY SEWER PLAN & PROFILE
8	S 184th ST & S 184th AVE & ROBIN CIRCLE SAN SEWER PLAN & PROFILE
9	S 184th TERRACE SANITARY SEWER PLAN & PROFILE
10	S 185th ST & S 185th CIRCLE SANITARY SEWER PLAN & PROFILE
11	S 180TH AVE & BLACKWALNUT ST SANITARY SEWER PLAN & PROFILE
12	REDWOOD ST SANITARY SEWER PLAN & PROFILE
13	S 181st ST SANITARY SEWER PLAN & PROFILE
14	REDWOOD ST & S 181st ST SANITARY SEWER PLAN & PROFILE
15	S 184TH TERRACE (RIVER OAKS) SANITARY SEWER PLAN & PROFILE
16	S 184TH TERRACE (RIVER OAKS) SANITARY SEWER PLAN & PROFILE
17	BLACKWALNUT ST & S 184TH AVE (RIVER OAKS) SS PLAN & PROFILE


GARDEN OAKS

LOTS 1 THRU 147 INCLUSIVE & OUTLOTS "A" THRU "D"
SANITARY SEWER - SECTION I

Located in the SE 1/4 of Section 17, Township 14, Range 11, of the 6th P.M.
SID NO. 313
SARPY COUNTY COUNTY, NEBRASKA

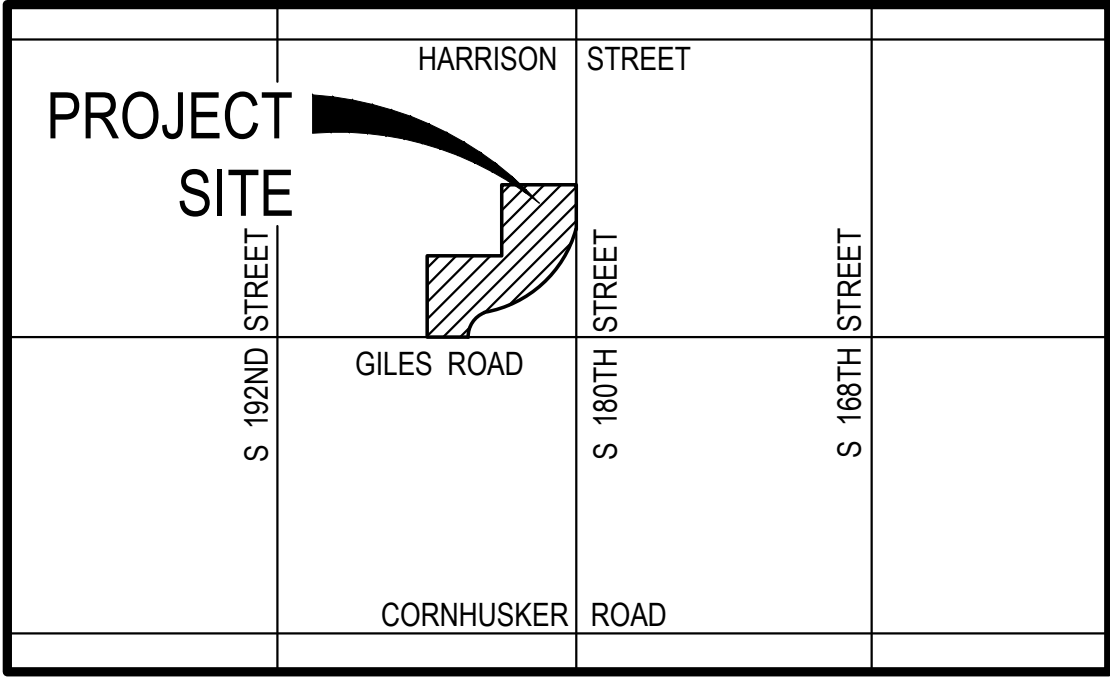

VICINITY MAP

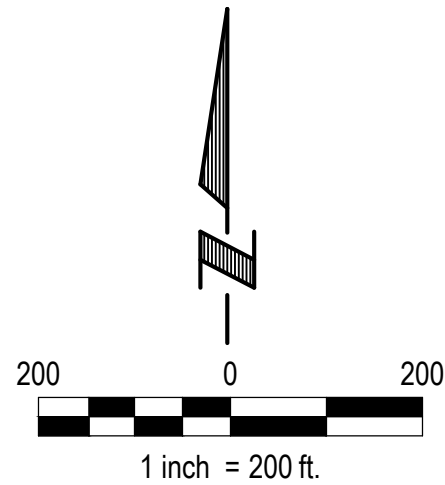

RECORD DRAWINGS


THESE PLANS HAVE BEEN REVISED TO
CONFORM TO CONSTRUCTION RECORDS

REVISION DATE: 6/19/2018 BY: HLB

CHECKED BY: RP

CONTRACTOR: Kersten Construction, Inc.

E & A CONSULTING GROUP, INC.

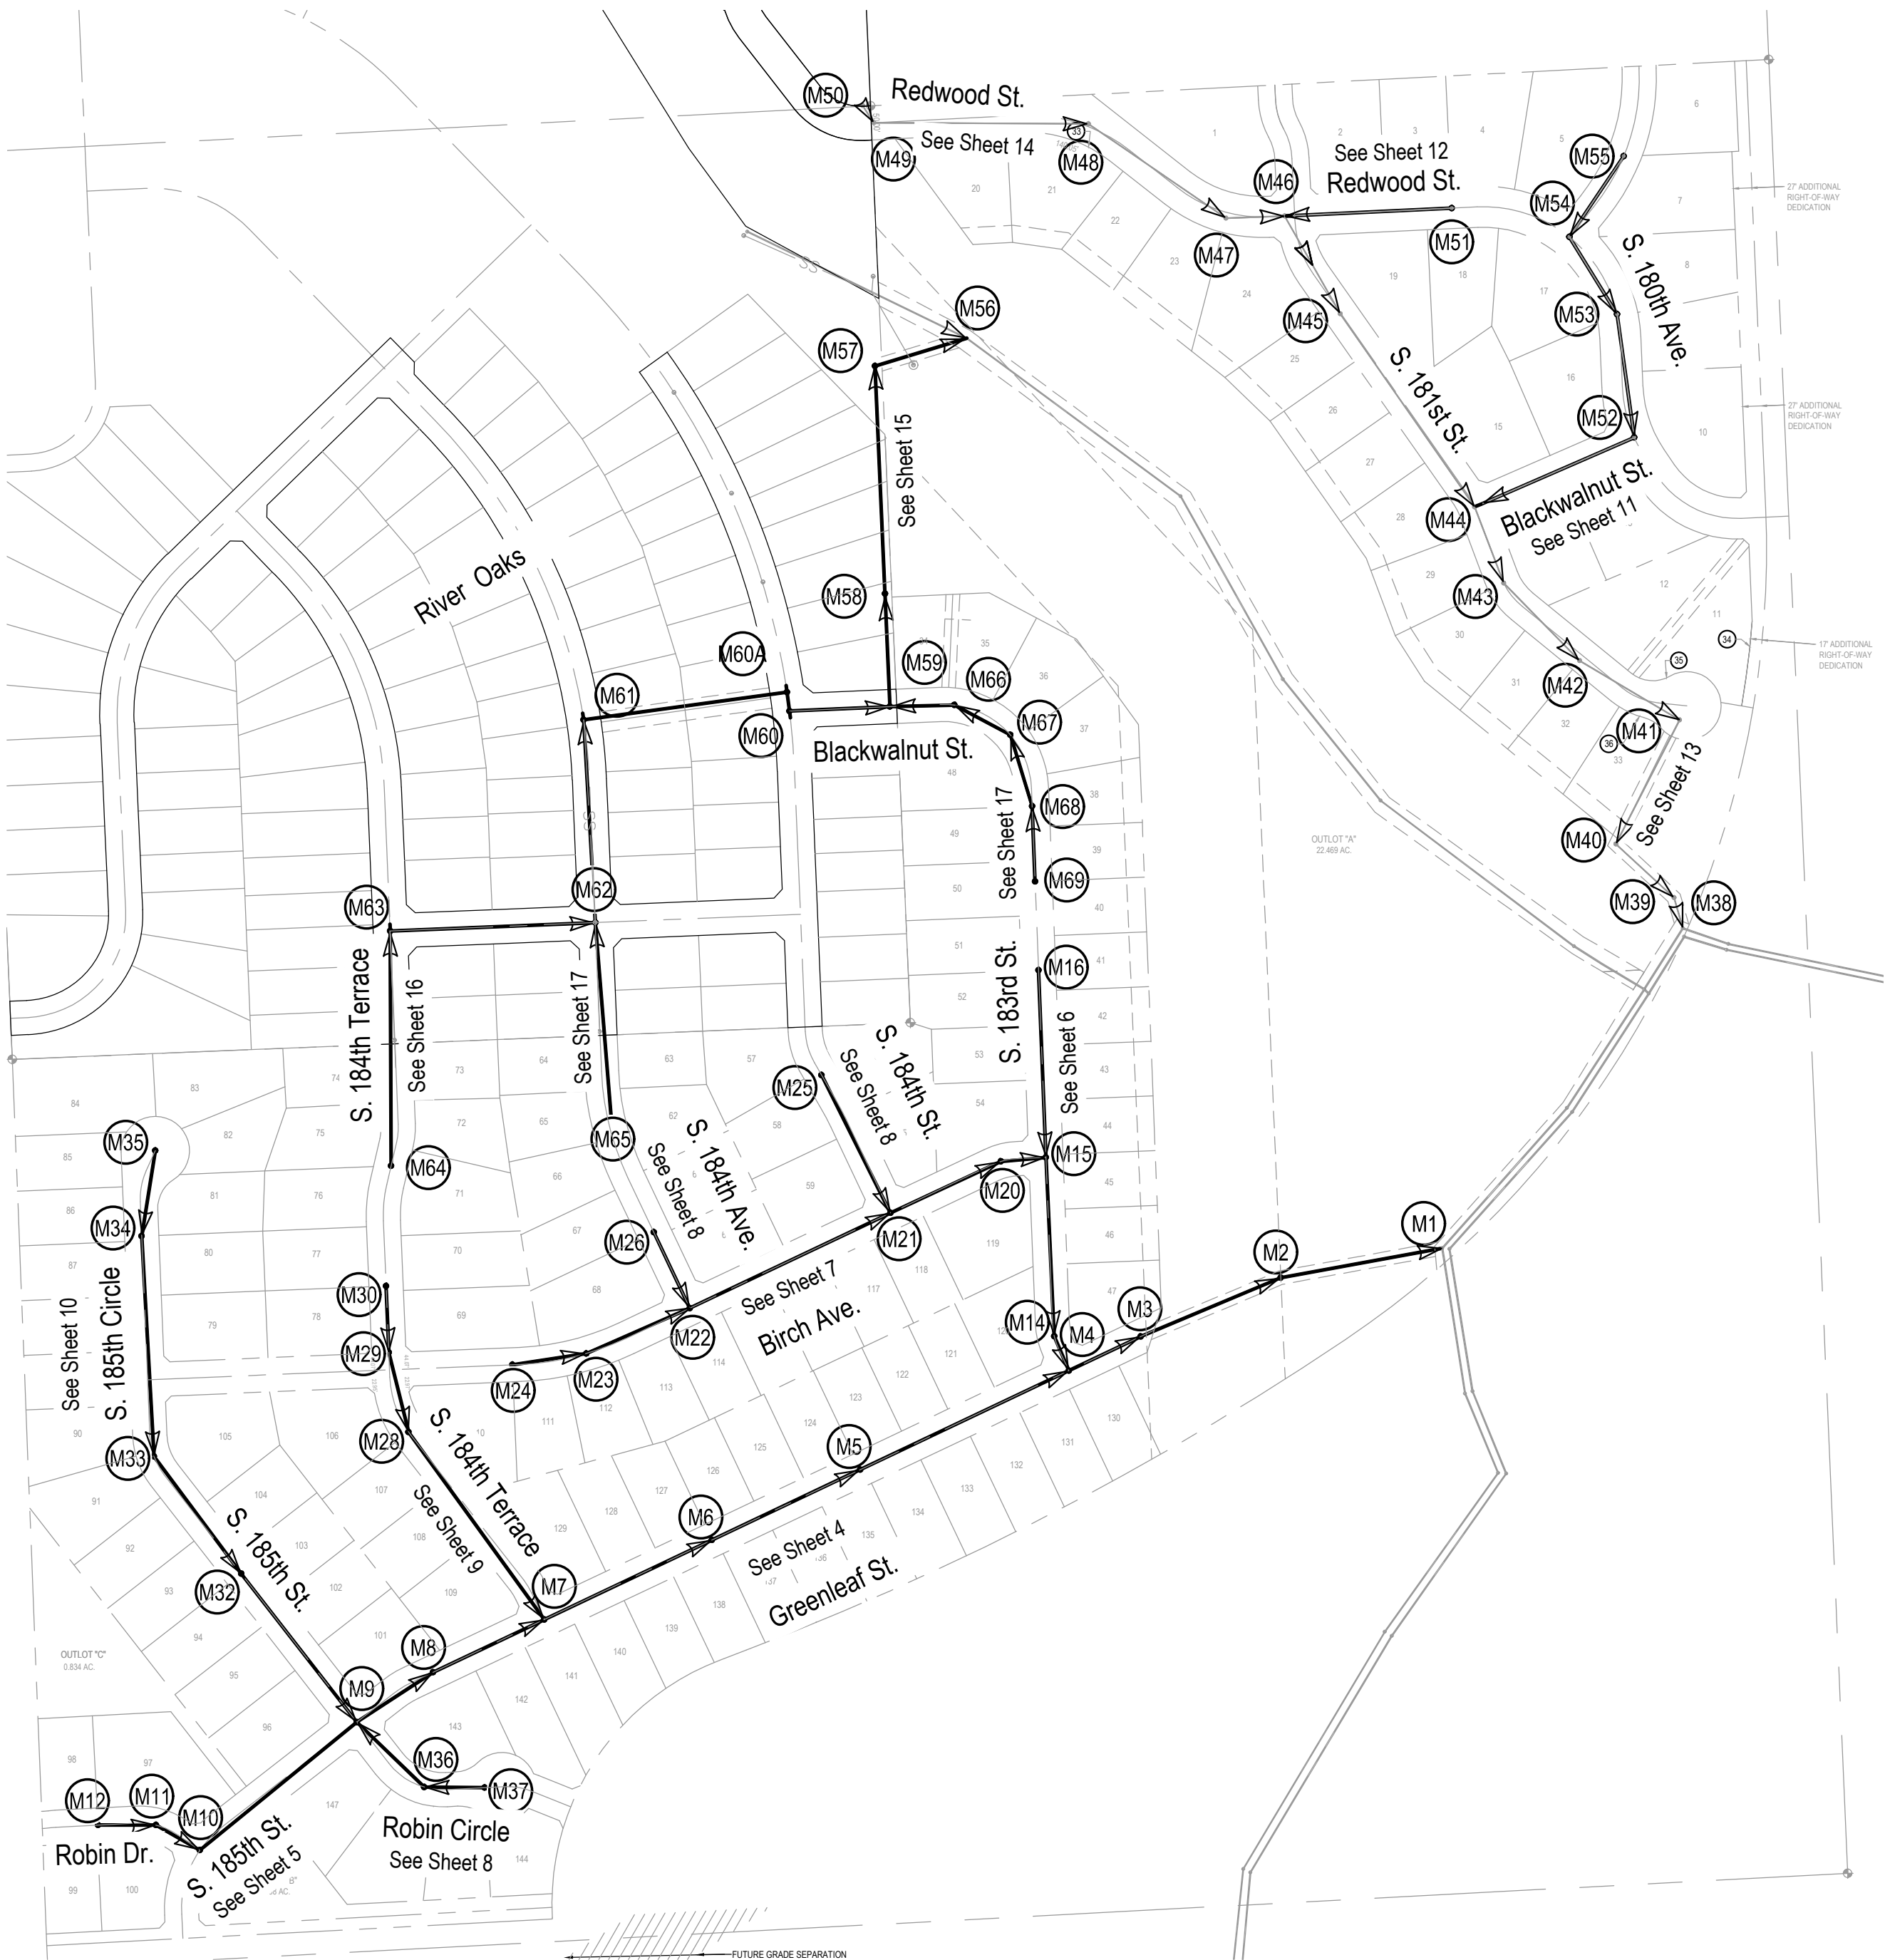

PROJECT INFORMATION

Project Number Assigned by PWD	SAR-20160414-3523-GP1	313	9/1/2016	5/1/2017
Grading Permit Project Number Assigned by PWD		SID Number	Estimated Start Date	Estimated Completion Date
Project Name	Garden Oaks (Lots 1-147 & OL 'A'-D')	Subdivision Name	Garden Oaks	
Address	S 180TH & Giles Road	City	Sarpy County	NE 68136
City Council Resolution Number Granting Project Approval		City Council Ordinance Number Granting Project Approval		City Council Resolution/Ordinance Approval Date

PROJECT DESCRIPTION

Sanitary Sewer System

APPLICANT

MWSD, LLC
Tom Falcone
410 S. 185th Street
Omaha, NE, 68022
402-981-0727
402-315-9784
tfalcone300@hotmail.com

INSPECTOR

E & A Consulting Group, Inc.
Randy Pierce
10909 Mill Valley Road, Suite 100
Omaha, NE 68154
P: 402.895.4700
F: 402.895.3599
Email: rpierce@eacg.com


DESIGNER

E & A Consulting Group, Inc.
Jamie Winterstein
10909 Mill Valley Road, Suite 100
Omaha, NE 68154
P: 402.895.4700
F: 402.895.3599
jwinterstein@eacg.com

CONTRACTOR


Kersten Construction Inc.
Randy Kersten
11050 S 204th St
Gretna, NE
P: 402.332.4141
F: 402.332.5822
randyk@kerstenconst.com

E & A CONSULTING GROUP, INC.
Engineering • Planning • Environmental & Field Services

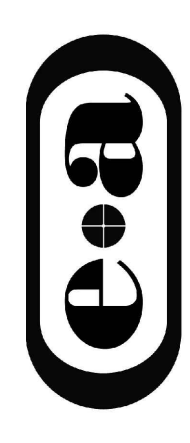

GARDEN OAKS
LOTS 1 THRU 147 INCLUSIVE &
OUTLOTS "A" THRU "D"
SARPY COUNTY, NEBRASKA

COVER

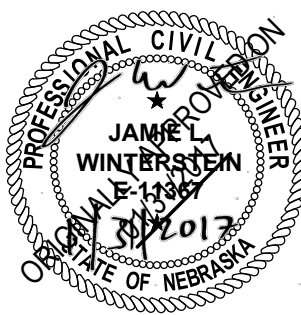

Revisions	Description
0	As-Built

Proj No:	P2015.497.001
Date:	10/20/2016
Designed By:	JLW
Drawn By:	JLW
Scale:	SEE PLAN
Sheet:	1 of 17

GENERAL CONSTRUCTION NOTES

1. The time limit to complete all work shall be Fifty (50) working days.
2. All project procedures, materials, bonds and reserves shall conform to the City of Omaha Specifications for Public Works Construction 2014, Third Edition, and any additions thereto. It will be the responsibility of the CONTRACTOR to be aware of the contents of the aforementioned specifications. The aforementioned publication can be found at <http://www.cityofomaha.org/pw/index.php/standard-specifications>
3. Barricades shall conform to Omaha Public Works "Barricading Standards, Specifications, Methods & Materials", and/or the "Manual on Uniform Traffic Control Devices", and any additions thereto. The aforementioned publications can be found at <http://cityofomaha.org/pwredo/images/stories/pdfs/City%20of%20Omaha%20Barricading%20Standards.pdf>
4. The INSPECTOR must assure the CONTRACTOR adheres to and meets all construction specifications & plans; maintenance, safety, workmanship, & testing requirements; and applicable regulatory compliance issues.
5. Approval must be obtained from the Sarpy County Engineer for all applicable public improvements prior to the commencement of construction. The CONTRACTOR shall check with the INSPECTOR for Sarpy County Public Works approval of the project before starting work.
6. The CONTRACTOR and INSPECTOR must assure all impacted government agencies (Sarpy County, State of Nebraska, Corps of Engineers, Papio-Missouri River Natural Resource District, United States Federal Government, etc.) have granted all applicable permission to proceed with construction prior to mobilization. Furthermore, 48 hours prior to the commencement of construction, the INSPECTOR must notify all concerned parties that work will be proceeding within each impacted government agency jurisdictional boundary.
7. Construction found to be unacceptable to the Sarpy County Public Works Department shall be removed and replaced at the CONTRACTORS expense.
8. The INSPECTOR must notify the following Sarpy County Public Works Department personnel 48 hours prior to all preconstruction meetings and 48 hours prior to the start of any construction: Bill Herr (Phone: 402-537-6909; email: HerrB@sarpy.com)
9. The INSPECTOR must submit weekly progress reports to the following City of Omaha Public Works Department employee no later than the following week ending date: Brian Becker (Phone: 402-537-6909; email: HerrB@sarpy.com)
10. The INSPECTOR must notify the following City of Omaha Public Works Department personnel 48 hours prior to lane closures and 24 hours prior to lane restrictions: Bill Herr Becker (Phone: 402-537-6909; email: HerrB@sarpy.com)
11. All operations conducted on the premises, including the warming-up, repair, arrival, departure, or running of trucks, earthmoving equipment, construction equipment, and any other associated equipment shall be limited to the period between 7:00 A.M. and 6:00 P.M. Monday thru Friday; and, no earthmoving or grading operations shall be conducted on the premises on Saturdays or Sundays or legal holidays, unless waived by the INSPECTOR and Sarpy County Public Works Department.
12. The CONTRACTOR shall notify all impacted utility companies via One Call (dial 811 or 800-331-5666), 48 hours before work is started to verify utility locations.
13. The existence and location of any overhead or underground utility lines, pipes, or structures shown on these plans are obtained by a research of the available records. Existing utilities are approximate and for record purposes. Existing utilities are located on plans only for the convenience of the CONTRACTOR. Existing utility service laterals may not be shown on the plans. The CONTRACTOR shall locate all underground and overhead interference's which may affect his operation during construction and shall take all necessary precautions to avoid damage to same.
14. The CONTRACTOR shall take all precautionary measures necessary to protect existing utility lines, structures and street improvements which are to remain in place, from damage, and all such improvements or structures damaged by the CONTRACTOR'S operations shall be repaired or replaced satisfactory to the INSPECTOR and owning utility company at the expense of the CONTRACTOR.
15. All construction shall be as shown on these plans. Any revisions shall have the prior written approval of the DESIGNER and Sarpy County Public Works Department.
16. Construction may require the disturbance of existing drainage and erosion control measures. The CONTRACTOR shall make himself aware of the existing drainage and erosion control measures prior to bidding this work. A copy of the Grading and Erosion Control Plan SAR-20160414-3523-GP1 is available for review at the office of the DESIGNER and INSPECTOR. The function of these items must be maintained throughout construction with emphasis placed on restoring their integrity prior to any rainfall event. Erosion control improvements have been constructed on this site, including terraces, silt fencing, and temporary sediment basins. The CONTRACTOR shall be responsible for prompt reconstruction of any erosion control improvements disturbed by his operations. All disturbed erosion control improvements shall be fully reconstructed at the end of each working day prior to leaving the site.
17. Elevations are referenced to U.S.G.S. Datum.
18. CONTRACTOR shall adjust all new and existing inlets, valve boxes, manhole rims, and sewer clean outs, etc. to finish grade as applicable whether or not they are shown on the plans.
19. The CONTRACTOR must adhere to good housekeeping best management practices at all times. Good housekeeping best management practices focus on keeping the work site clean and orderly while handling materials and waste in a manner that eliminates the potential for pollutant runoff.

GENERAL CONSTRUCTION NOTES

20. The construction documents (e.g., Contract, Bond, Insurance, Specifications, and Plans) are essential and a requirement in one part is as binding as though occurring in all. Thus, the construction documents are complementary in nature. The documents describe and provide the complete construction project. The CONTRACTOR may not take advantage of any apparent construction project errors or omissions. The CONTRACTOR shall notify the INSPECTOR promptly of any omissions or errors. In the case of a discrepancy between parts of the construction documents, the most stringent construction methodology shall rule.
21. The Contractor shall be responsible for coordinating their work with the Engineer in requesting line stakes and grades. The Owner will not be responsible for delays due to lack of grades or line stakes.
22. The Contractor shall be charged for replacing construction stakes and lot pins which are destroyed by his operations.
23. The Contractor is hereby referred to Subsection 4.07 of the Standard Specifications relative to cleaning of the work area. The final estimate will not be processed until the Contractor has satisfactorily cleaned and flushed the pavement slab of all rubbish, excess material, mud and debris, and all parts of the work area have been left in a neat and presentable manner. All disturbed right-of-way areas shall be restored to a level and smooth section prior to acceptance of the work.
24. The Contractor shall place silt fence as shown and as directed by the Engineer to prevent sediment from leaving the construction site.
25. Contractor is referred to the following City of Omaha Standard Plates:

ITEMS	STANDARD PLATE	REVISION DATE
Sewer Bedding Detail	700-01	12/10/2013
Cast Iron Manhole Rings, Covers, Manhole Steps	700-90 (1 & 2)	12/10/2013
Manhole Detail	700-45	06/18/2014
Manhole Ring Retainer	700-45	06/18/2014
Typical Riser Detail	700-45	12/10/2013

Standard Plates are available from the City of Omaha Public Works Department, 1819 Farnam St., Suite 600, Omaha NE. 68183, PH 402.444.5220. Plates may also be downloaded via the Internet from the City of Omaha Web Site at: <http://www.cityofomaha.org/pw/index.php/contractors-consultants2/contractors>

26. Service line max slope shall be 12%. Mainline sewers deeper than 16' deep require service risers.

SANITARY SEWER CONSTRUCTION NOTES

1. All project procedures, materials, bonds and reserves shall conform to the City of Omaha Specifications for Public Works Construction 2014, and any additions thereto. The aforementioned publication can be found at: <http://www.cityofomaha.org/pw/index.php/contractors-consultants2/contractors/standard-plates-curb-ramps-and-specification>
2. The sanitary sewer system (pipe, manholes, special structures, service lateral, etc.) must be placed, compacted, and backfilled in accordance with City of Omaha Specifications for Public Works Construction.
3. The INSPECTOR is required to be on site at all times during construction of the sanitary sewer. The CONTRACTOR shall give the INSPECTOR at least 48 hours notice prior to beginning work at the start of construction or after an interval of not working on the sanitary sewer.
4. The slope on 6" & 8" sanitary sewer service stubs shall be between 1/4" per foot and 3/8" per foot Unless Noted Otherwise.
5. Solid cast iron covers shall be used on all sanitary sewer manholes.
6. The INSPECTOR must assure all sanitary lines, manholes and service laterals are cleaned of debris (leaves, stone, dirt, construction material, etc.) prior to the APPLICANT taking ownership.
7. No sanitary sewer service connections to any building shall be permitted prior to final acceptance by the Sarpy County Public Works Department, Bill Herr (Phone: 402.537.6909; Email: HerrB@sarpy.com), which shall include approved rectification of all punch list items and the submittal of mylar as-built drawings.
8. Concrete for manholes and pipe shall be L65M using either Type II Portland cement or Type I Portland cement if modified to require that the tricalcium aluminate content shall not exceed eight percent (8%). The cement for manhole grout shall be the same as that for manhole concrete.
9. The sanitary sewer pipe may be VCP, PVC (Solid Wall) or DIP. The 6 inch pipe shall be VCP, PVC (solid wall, SDR 23.5), or DIP. Solid wall PVC pipe and fittings having an inside diameter 8" or greater shall be in accordance with SDR35. Solid wall PVC pipe and fittings 18" and greater shall be in accordance with ASTM F679, Std. Spec. for Large Diameter Plastic Gravity Sewer Pipe and Fittings.
10. Six inch & Eight inch sewer stubs shall be installed from the main sewer to the locations shown on the plans and properly marked in accordance with the specifications. The slope of the sewer stubs shall be a minimum of 2 percent, and in no case shall the stub depth at the property line be less than 10 feet unless otherwise approved by the Engineer. All wyes and stubs shall be placed as directed by the Engineer. Service line max slope shall be 12%. Mainline sewers deeper than 16' deep require service risers.
11. The Contractor shall be required to perform a low pressure air leakage test for all Sanitary Sewer Pipe per Section 703.04 of the City of Omaha Standard Specifications and ASTM F-1417, Low Pressure Air Testing. Use 0.5 psi drop test. Test equipment to have 0-15 psi maximum pressure gauge with minimum divisions of 0.10 psi up to a maximum of 0.25 psi divisions and an accuracy of +- 0.04 psi. Test times are provided in the table below per diameter and length.

MINIMUM SPECIFIED TIME REQUIRED FOR A 0.5 PSIG PRESSURE DROP FOR SIZE AND LENGTH OF PIPE INDICATED FOR Q = 0.0015

1 Pipe Diameter (in.)	2 Minimum Time (min: sec)	3 Length for Minimum Time (ft)	4 Time for Longer Length (sec)	Specification Time for Length (L) Shown (min: sec)							
				100 Ft	150 Ft	200 Ft	250 Ft	300 Ft	350 Ft	400 Ft	450 Ft
4	1:53	597	.190 L	1:53	1:53	1:53	1:53	1:53	1:53	1:53	1:53
6	2:50	398	.427 L	2:50	2:50	2:50	2:50	2:50	2:50	2:51	3:12
8	3:47	298	.760 L	3:47	3:47	3:47	3:47	3:48	4:26	5:04	5:42
10	4:43	239	1.187 L	4:43	4:43	4:43	4:57	5:56	6:55	7:54	8:54
12	5:40	199	1.709 L	5:40	5:40	5:42	7:08	8:33	9:58	11:24	12:50
15	7:05	159	2.671 L	7:05	7:05	8:54	11:08	13:21	15:35	17:48	20:02
18	8:30	133	3.846 L	8:30	9:37	12:49	16:01	19:14	22:26	25:38	28:51
21	9:55	114	5.235 L	9:55	13:05	17:27	21:49	26:11	30:32	34:54	39:16
24	11:20	99	6.837 L	1:24	17:57	22:48	28:30	34:11	39:53	45:35	51:17
27	12:45	88	8.653 L	14:25	21:38	28:51	36:04	43:16	50:30	57:42	64:54
30	14:10	80	10.683 L	17:48	26:43	35:37	44:31	53:25	62:19	71:13	80:07
33	15:32	72	12.926 L	21:33	32:19	43:56	53:52	64:38	75:24	86:10	96:57
36	17:00	66	15.384 L	25:39	38:28	51:17	64:06	76:55	89:44	102:34	115:23
42	19:54	57	20.942 L	34:54	52:21	69:49	87:15	104:42	122:10	139:37	157:04
48	22:47	50	27.352 L	45:35	68:23	91:11	113:58	136:46	159:33	182:21	205:09
54	25:31	44	34.618 L	57:42	86:33	115:24	144:15	173:05	201:56	230:47	259:38
60	28:20	40	42.738 L	71:14	106:51	142:28	178:05	213:41	249:18	284:55	320:32

Note: If there has been no leakage (zero psig drop) after one hour of testing, the test section shall be accepted and the test complete. (See Section 7.5.)

12. Deflection tests shall be performed on all flexible pipe installations in accordance with Section 703.04 of the City of Omaha Standard Specifications and State of Nebraska Title 123.
13. All sewer pipe 8 inch internal diameter and larger installed under this project shall be inspected by T.V. camera by an independent sewer inspection service. The T.V. inspection will be paid for by the Owner. Video shall be compatible DVD format.
14. The contractor shall use caution in placing the backfill around and above the pipe to prevent disturbance of the joints or pipe alignment. No rock or stone larger than six (6) inches shall be placed within three (3) feet of the top of the pipe. A minimum four (4) feet of compacted cover above the top of the pipe shall be provided before the use of wheel mounted mechanical tampers (free drop hammers), hydraulic ram tampers or other heavy tamping equipment will be permitted.
15. Manholes shall be installed in accordance with Section 703 of the City of Omaha Standard Specifications including, but not limited to, frame seal installation and infiltration testing.
16. Welded steel pipe encasement shall have a smooth interior wall with minimum thickness of 3/16". Manufactured casing spacers, skids and end seal caps shall be considered subsidiary to Line Items 13 and 14.
17. All work shall conform to Title 123 - Rules and Regulations for the Design, Operation, and Maintenance of Wastewater Works.

ne1call.com

Nebraska 811
know what's below.
Call before you dig.

RECORD DRAWINGS

THESE PLANS HAVE BEEN REVISED TO
CONFORM TO CONSTRUCTION RECORDS

REVISION DATE: 6/19/2018 BY: HLB

CHECKED BY: **RP**

CONTRACTOR: Kersten Construction, Inc.

E & A CONSULTING GROUP, INC.

E & A CONSULTING GROUP, INC.
Engineering • Planning • Environmental & Field Services

10906 Mill Valley Road, Suite 100 • Omaha, NE 68154
Phone: 402.895.4700 • Fax: 402.895.3599
www.eaag.com



GARDEN OAKS
LOTS 1 THRU 147 INCLUSIVE &
OUTLOTS "A" THRU "D"
SARPY COUNTY, NEBRASKA

NOTES




Revisions	Description	Date
0	As-Built	6/19/2018



Proj No:	P2015.497.001
Date:	10/20/2016
Designed By:	JLW
Drawn By:	JUN
Scale:	SEE PLAN
Sheet:	2 of 17

6/19/2018 12:42 PM K:\Projects\2015\497\p01\05 - 146-Building COVER000.dwg


Andy Bary

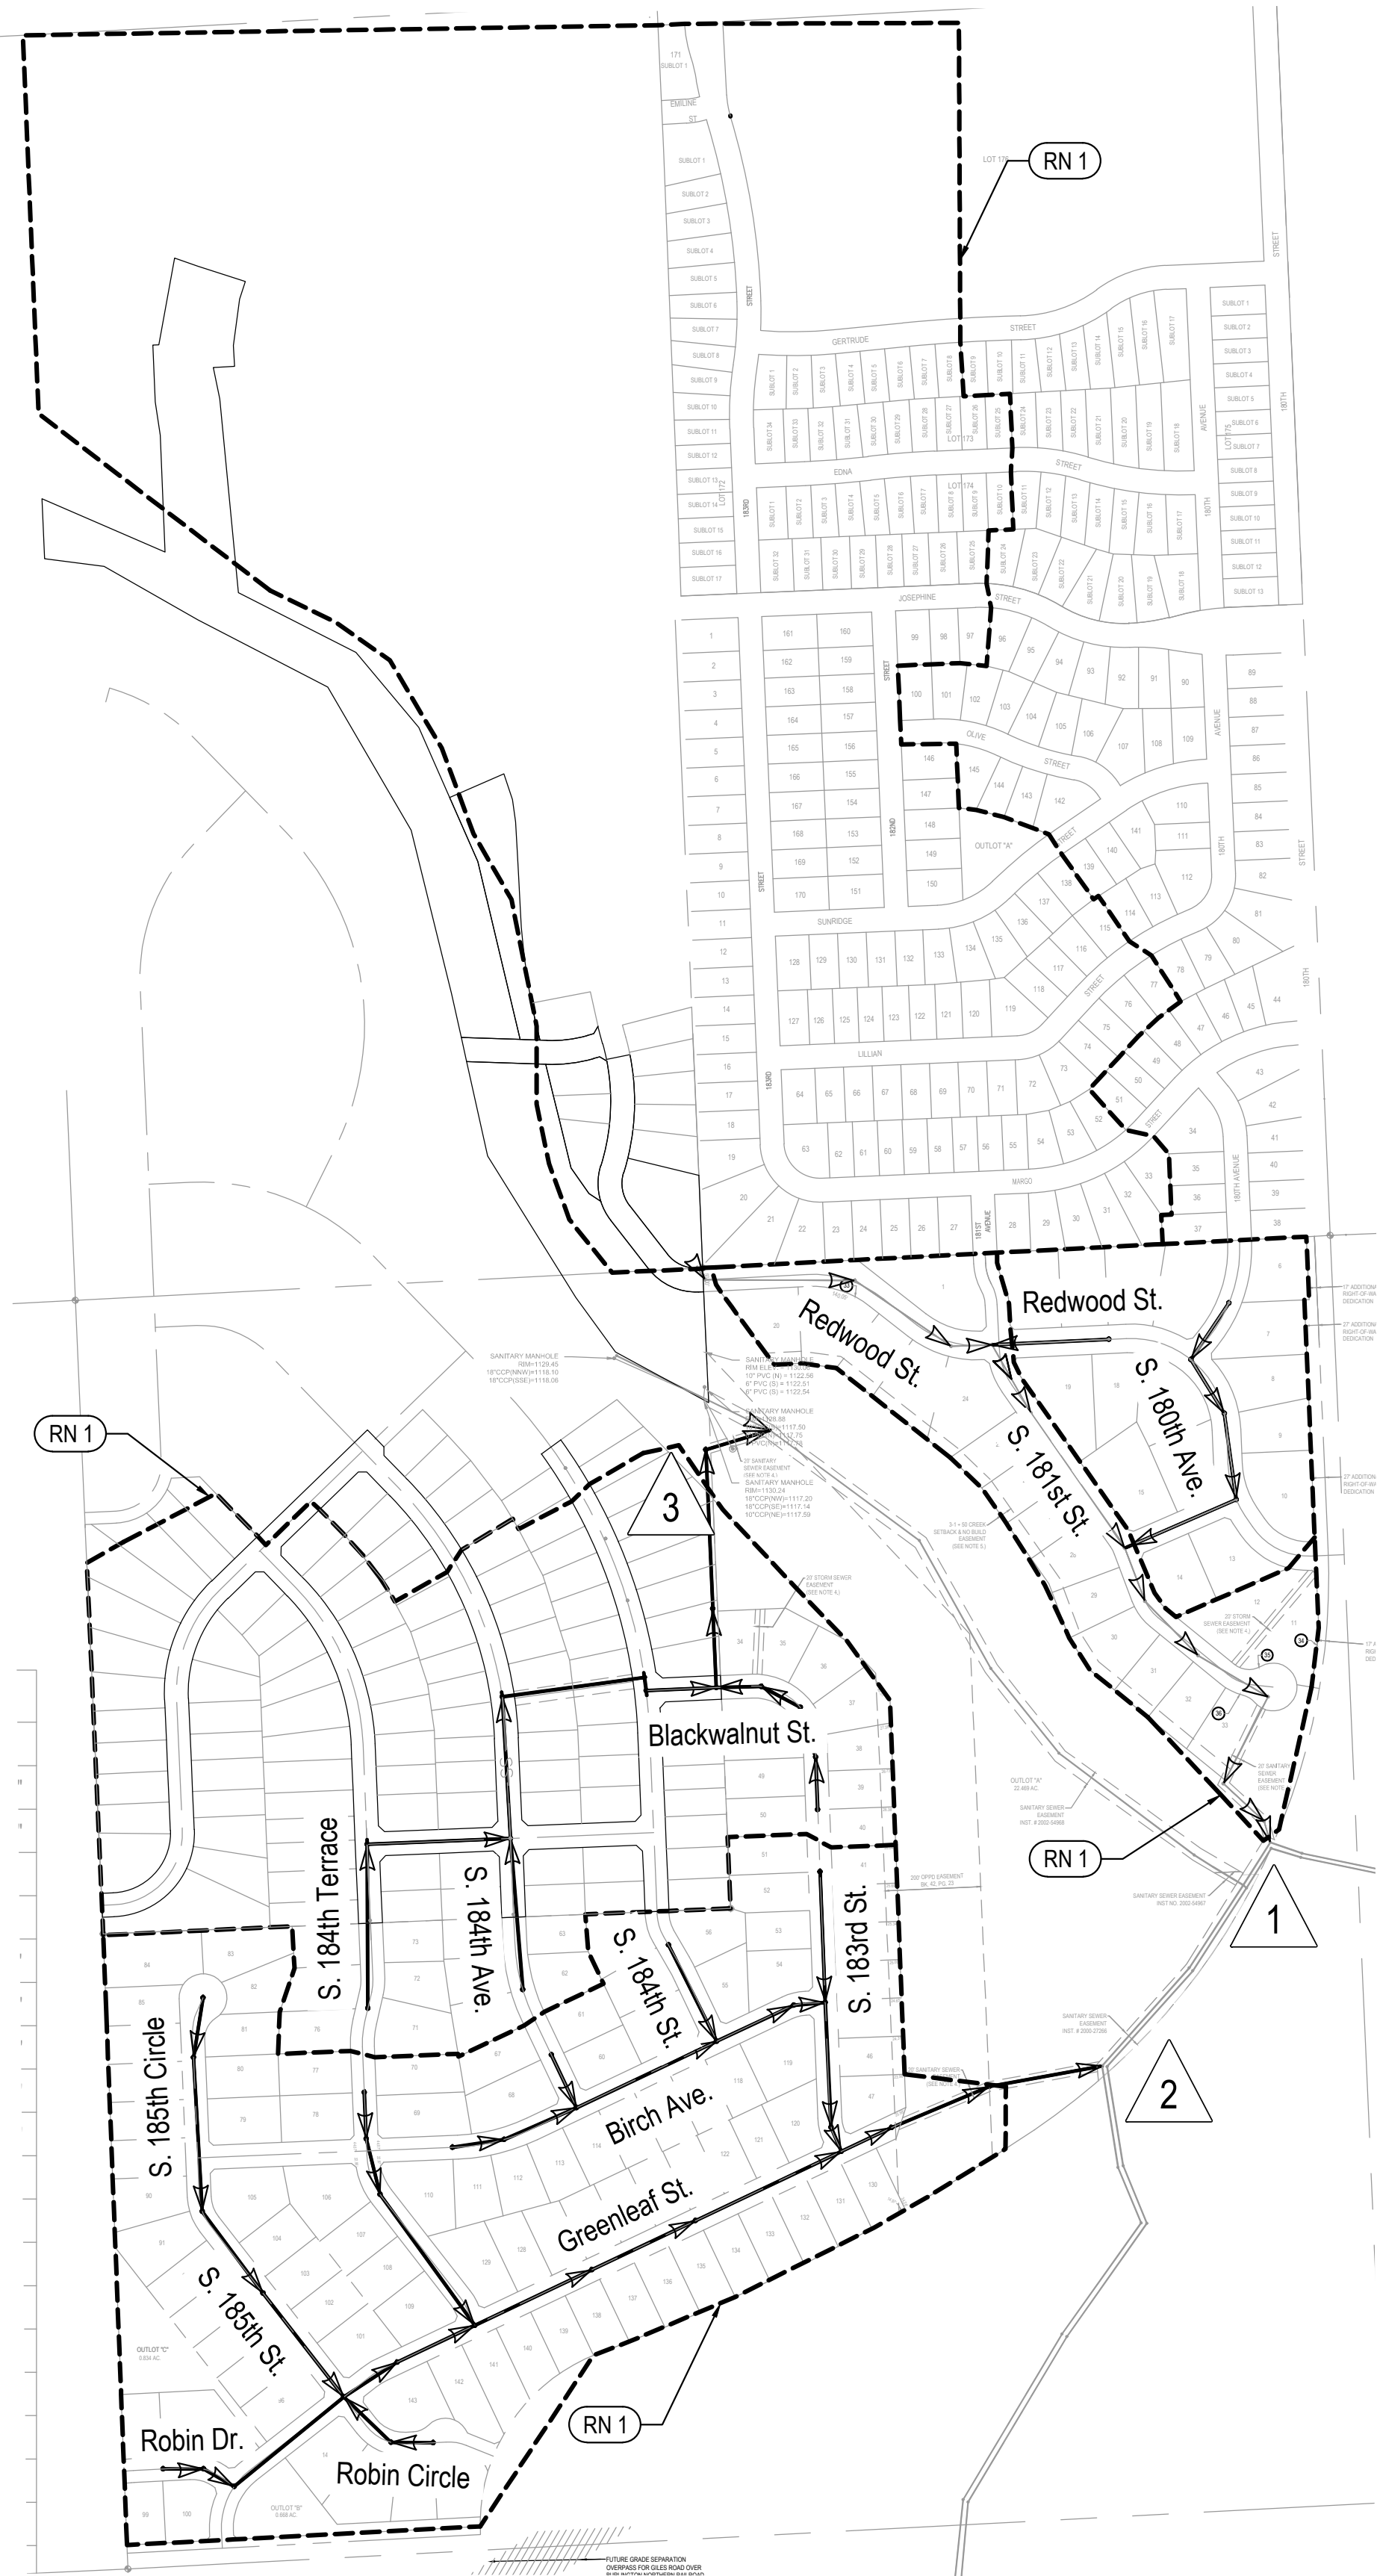


BASIN MAP

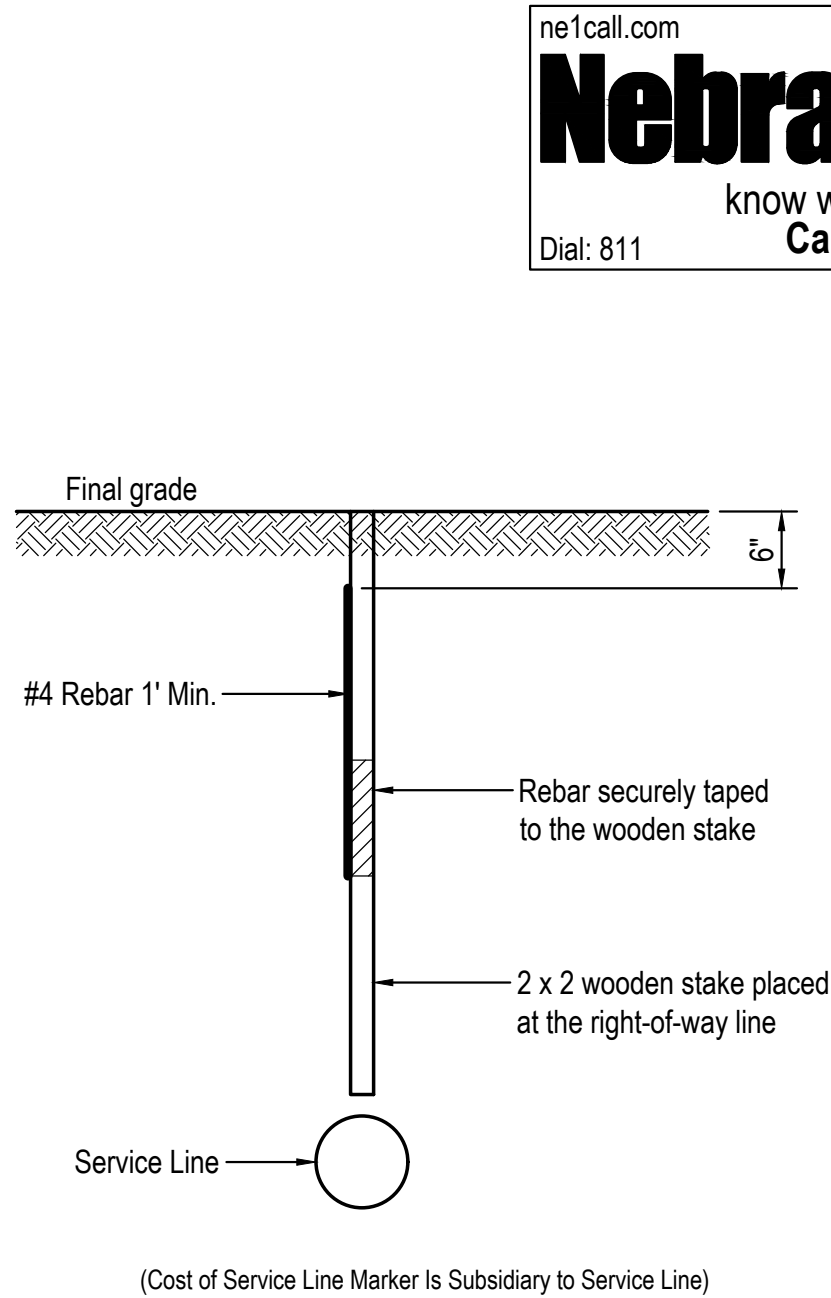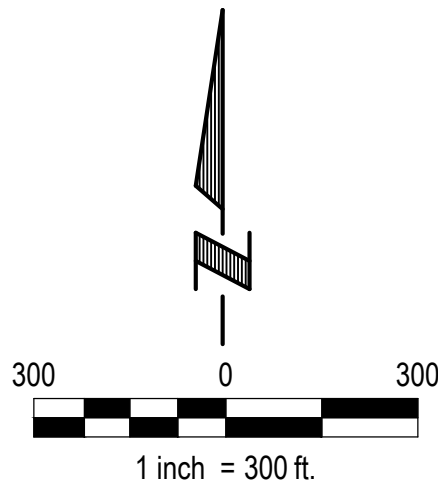

SERVICE LINE MARKER
NOT TO SCALE

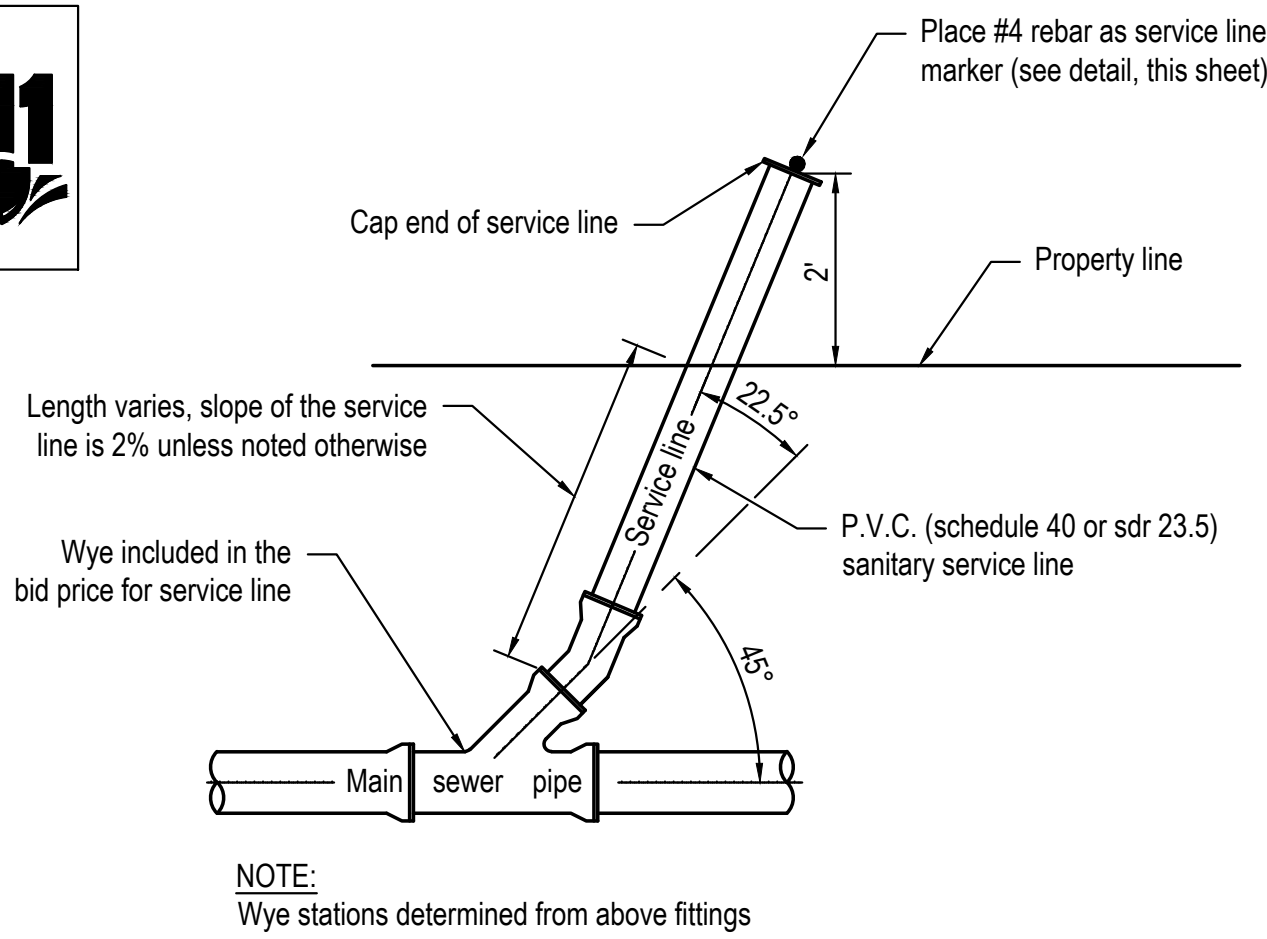

SANITARY SERVICE WYE DETAIL
NOT TO SCALE

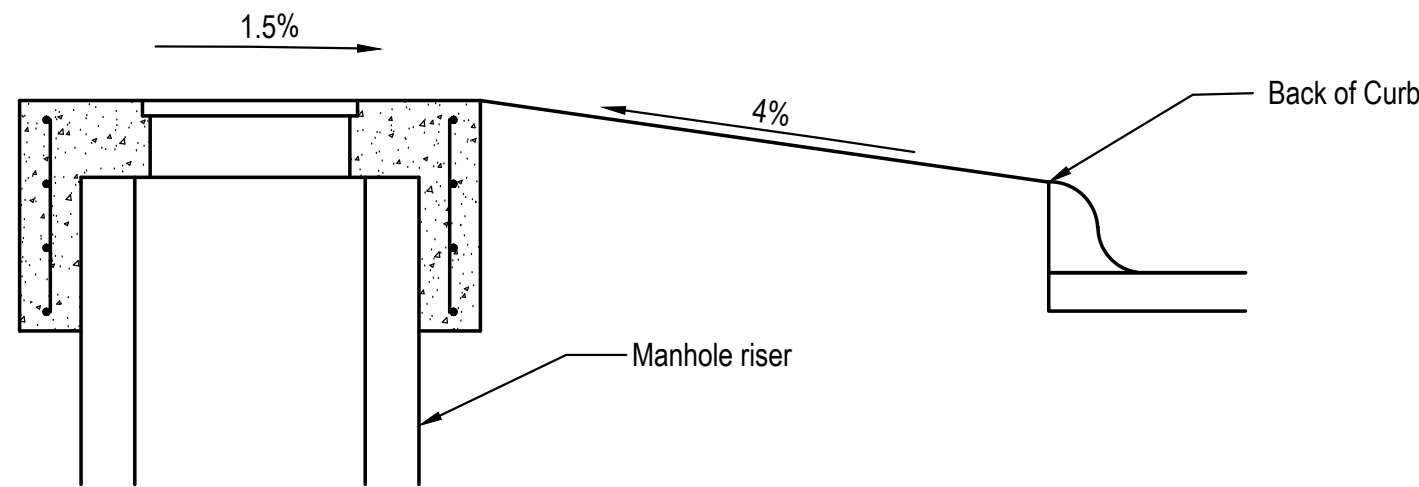

REINFORCED CONCRETE RING RETAINER
NOT TO SCALE

NO REFERENCE NOTES

RN 1 Drainage Boundary

DESIGN ASSUMPTIONS

Manning "n" - 0.013	
Aggregate Baseline Average Flow - 100 GPCD	Ref. Table 1-1 City of Omaha Sanitary Interceptor Sewer Element
Single Family Units Per Acre (Undeveloped Areas) - 4.26	Ref. Table 3-6 City of Omaha Sanitary Interceptor Sewer Element
Multi Family Units Per Acre (Undeveloped Areas) - 15.37	Ref. Table 3-6 City of Omaha Sanitary Interceptor Sewer Element
Capita per Unit - 2.58 SF, 1.76 MF	Ref. Table 3-5 City of Omaha Sanitary Interceptor Sewer Element
Commercial / Industrial Density - 100 people per 3.6 acres	Ref. Section 3.4 City of Omaha Sanitary Interceptor Sewer Element
Peaking Factor = 4.5 - 0.5* Log (Population) Standard City of Omaha Equation	Ref. Section 1.4 City of Omaha Sanitary Interceptor Sewer Element

SANITARY SEWER FLOW CALCULATIONS

IMPACT POINT	CONTRIBUTING AREA TYPE	AC.	UNITS	CAPITA	BASE FLOW (GPCD)	PEAKING FACTOR	PEAK FLOW* (GPCD)	PEAK FLOW* (GPD)	TOTAL PEAK FLOW (CFS)	COMMENTS
1	Sunridge - Single Family		166	428	100	3.18	318	136,370	0.211	8"at 0.4% Grade = 0.77 cfs
	Sunridge - Commercial	6.50		181	100	3.37	337	60,878	0.094	8"at 0.4% Grade = 0.77 cfs
	River Oaks - Single Family		131	338	100	3.24	324	109,355	0.169	8"at 0.4% Grade = 0.77 cfs
	Garden Oaks - Single Family		33	85	100	3.53	353	30,096	0.047	10"at 0.4% Grade = 1.39 cfs
	Accumulated								0.521	10"at 0.4% Grade = 1.39 cfs
2	Garden Oaks - Single Family		93	240	100	3.31	331	79,419	0.123	8"at 0.4% Grade = 0.77 cfs
3	River Oaks - Single Family		90	232	100	3.32	332	77,022	0.119	8"at 0.4% Grade = 0.77 cfs
	Garden Oaks - Single Family		21	54	100	3.63	363	19,684	0.030	8"at 0.4% Grade = 0.77 cfs
	Accumulated								0.273	8"at 0.4% Grade = 0.77 cfs

* Includes Calculated Peaking Factor (PF x 100 GPCD)

RECORD DRAWINGS

THESE PLANS HAVE BEEN REVISED TO CONFORM TO CONSTRUCTION RECORDS


REVISION DATE: 6/19/2018 BY: HLB

CHECKED BY: RP

CONTRACTOR: Kersten Construction, Inc.

E & A CONSULTING GROUP, INC.

E & A CONSULTING GROUP, INC.
Engineering • Planning • Environmental & Field Services

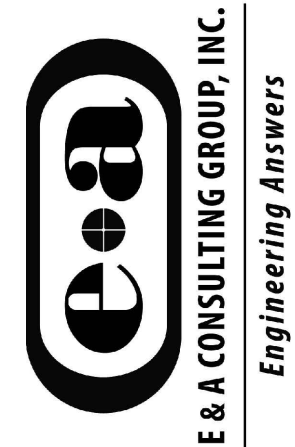

GARDEN OAKS
LOTS 1 THRU 147 INCLUSIVE &
OUTLOTS "A" THRU "D"
SARPY COUNTY, NEBRASKA

DETAILS



Revisions	Description	Date
0	As-Built	6/19/2018
1	See Plan	JUN
2	See Plan	JUN
6 INCH SERVICE LINE LOCATIONS					
LOT NO.	DIST. FROM PL		LENGTH L.F.	DEPTH FT.	WYE STA.
	DIST.	PROP. CORNER			
120	15'	SE	29'	11.5'	6+16
121	15'	SE	29'	12'	6+91
122	15'	SE	29'	12'	7+66
123	15'	SE	29'	13'	8+41
124	15'	SE	31'	13.5'	MH 5
125	15'	SE	29'	13.5'	10+00
126	15'	SE	29'	13.5'	10+80
127	15'	SE	31'	13'	MH 6
128	15'	SE	29'	13'	12+40
130	15'	NE	29'	11'	5+13
131	15'	NE	29'	11'	5+93
132	15'	NE	29'	12'	6+73

ne1call.com

Nebraska811

know what's below.
Call before you dig.

Dial: 811

6 INCH SERVICE LINE LOCATIONS					
LOT NO.	DIST. FROM PL		LENGTH L.F.	DEPTH FT.	WYE STA.
	DIST.	PROP. CORNER			
133	15'	NE	29'	12'	7+53
134	15'	NE	29'	12'	8+33
135	15'	NE	29'	13'	MH 5
136	15'	NE	29'	13'	9+93
137	15'	NE	29'	13'	10+73
138	15'	NE	29'	13'	MH 6
139	15'	NE	29'	13'	12+33

CONSTRUCT SANITARY SEWER MANHOLE						
ID	Sanitary Sta.	Dia.	Details	Northing	Easting	V.F.
2	2+40.01	54"	RIM = 1121.34 INV IN = 1113.54 (8") INV OUT = 1113.34 (8")	512997.57	2685958.38	8.0
3	4+61.86	54"	RIM = 1125.20 INV IN = 1114.63 (8") INV OUT = 1114.43 (8")	512911.67	2685753.93	10.8
4	5+78.04	54"	RIM = 1127.29 INV IN = 1115.29 (8") INV OUT = 1115.29 (8")	512861.88	2685649.00	12.2
5	9+15.65	54"	RIM = 1139.29 INV IN = 1124.67 (8") INV OUT = 1124.47 (8")	512717.22	2685344.10	14.8
6	11+55.65	54"	RIM = 1150.11 INV IN = 1134.69 (8") INV OUT = 1134.49 (8")	512614.38	2685127.34	15.6

500050

1 inch = 50 ft.

RECORD DRAWINGS



THESE PLANS HAVE BEEN REVISED TO CONFORM TO CONSTRUCTION RECORDS

REVISION DATE: 6/19/2018 BY: HLB

CHECKED BY:

CONTRACTOR: Kersten Construction, Inc.

E & A CONSULTING GROUP, INC.

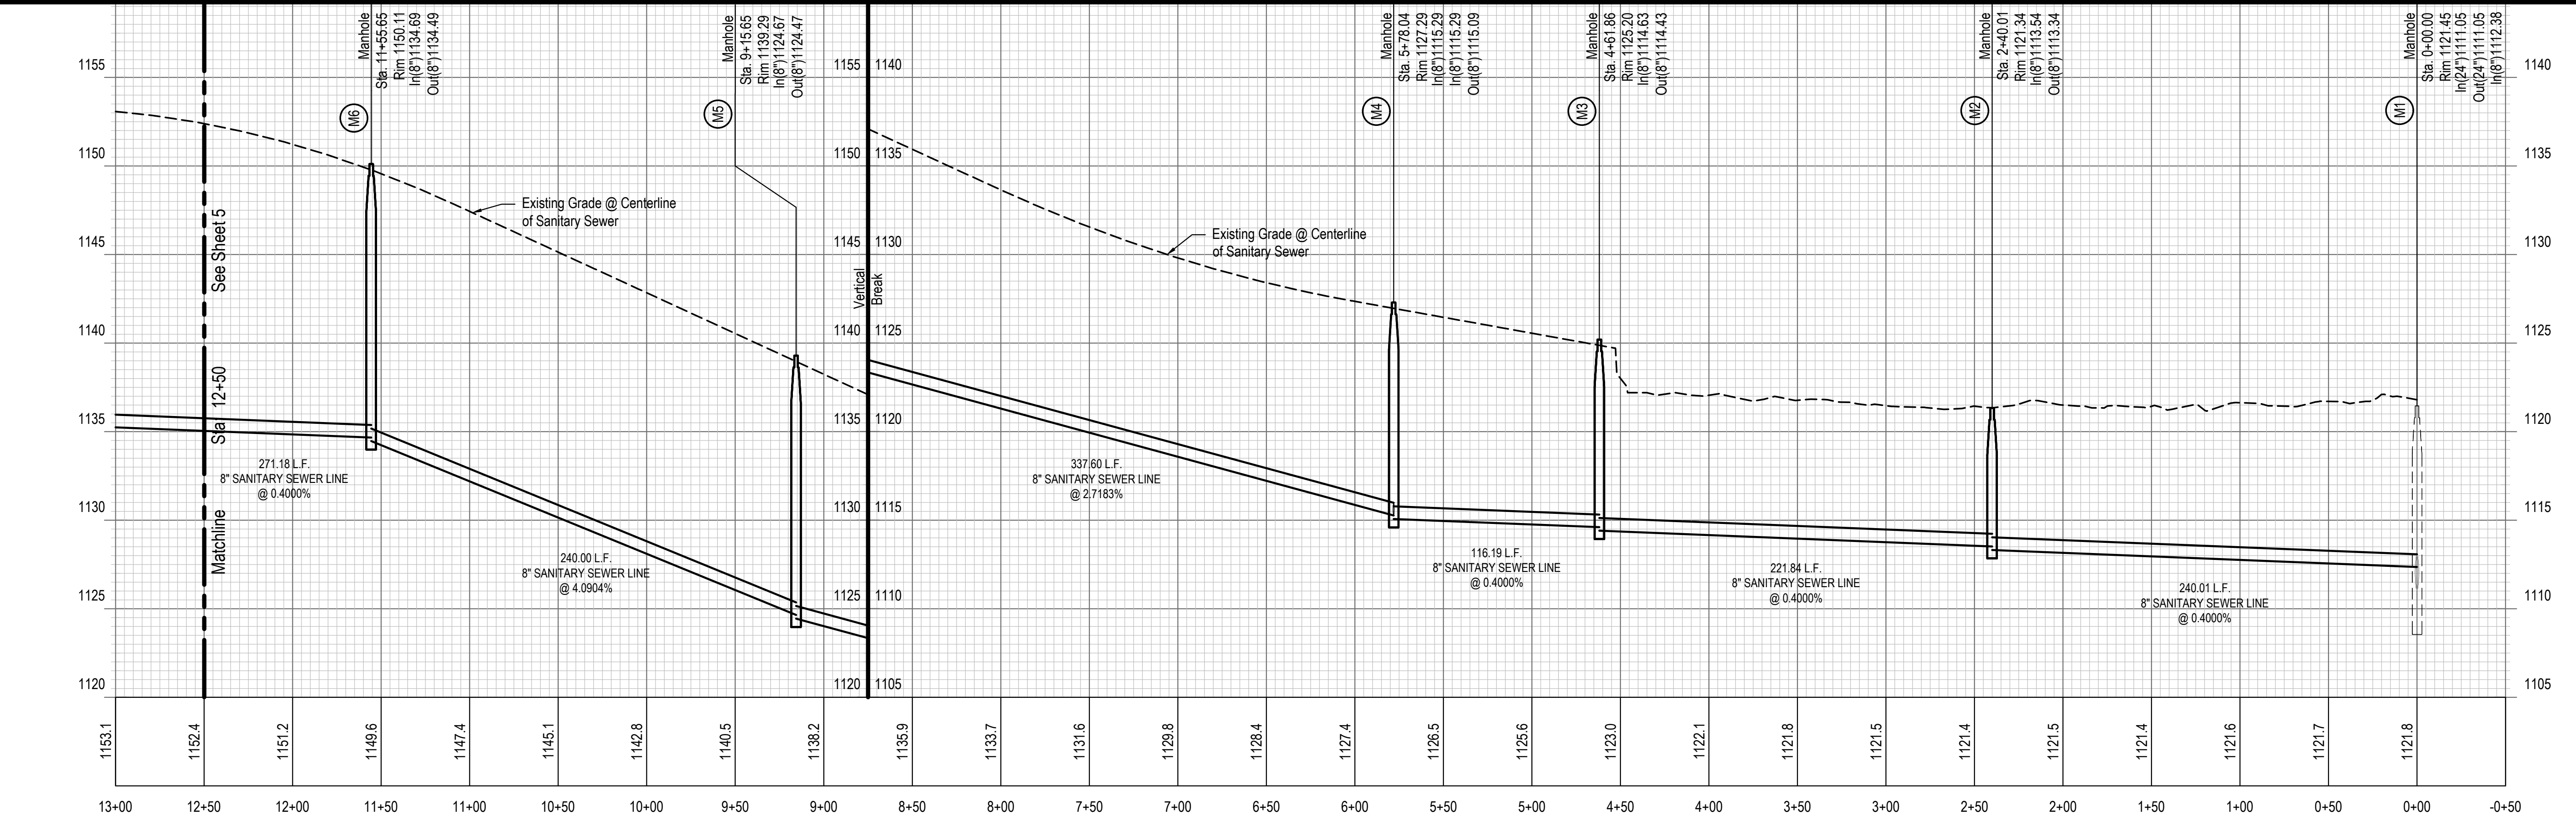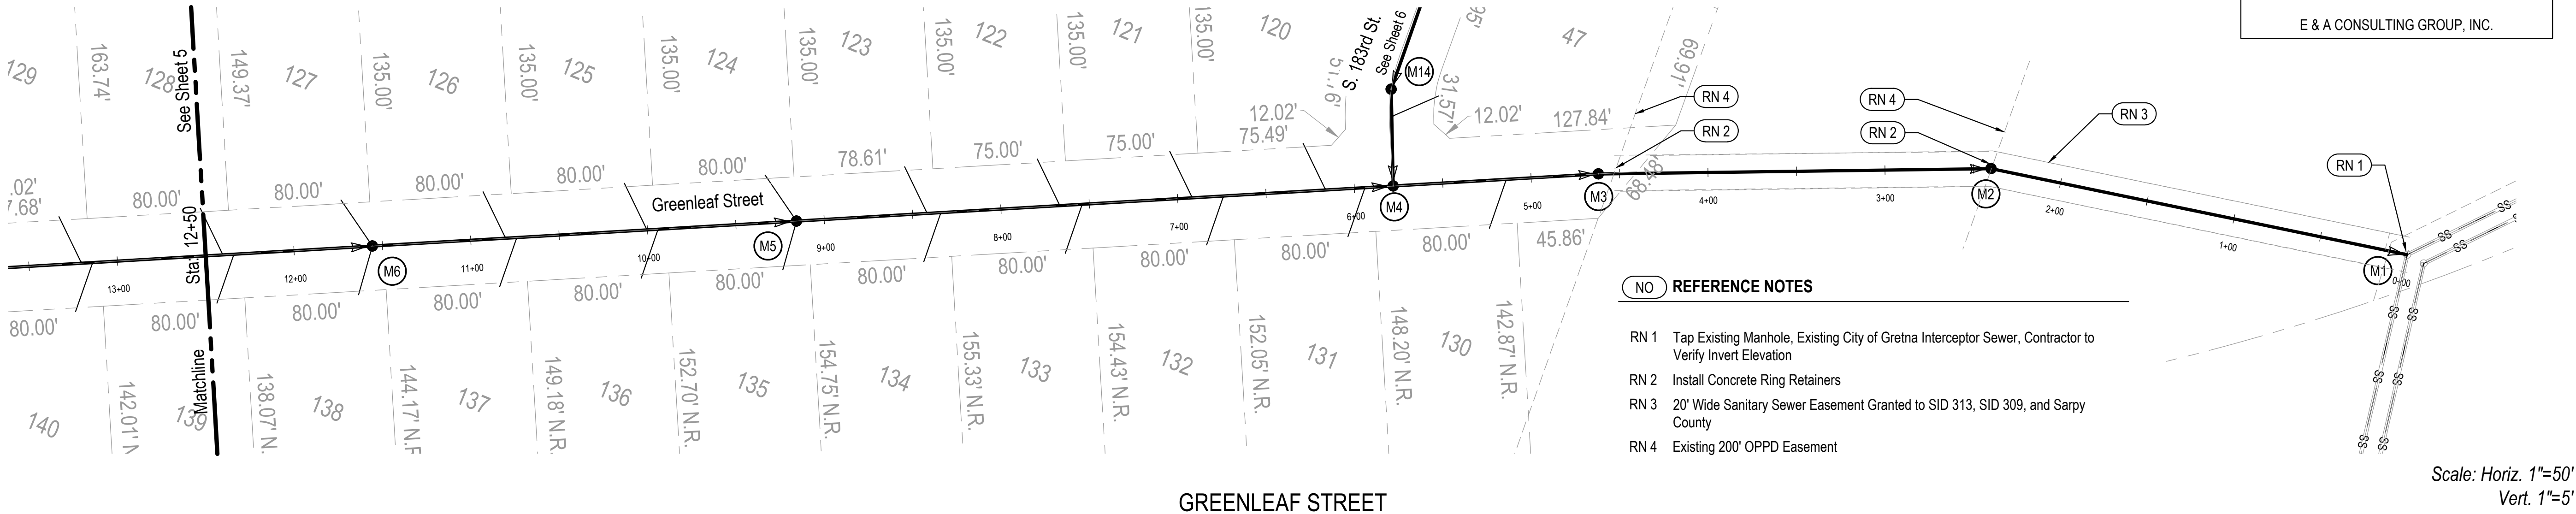

E & A CONSULTING GROUP, INC.
Engineering • Planning • Environmental & Field Services



GARDEN OAKS
LOTS 1 THRU 147 INCLUSIVE &
OUTLOTS "A" THRU "D"
SARPY COUNTY, NEBRASKA

GREENLEAF STREET
SANITARY SEWER PLAN
& PROFILE




Revisions		Description	
No.	Date	By	As Built
0	6/19/2016	JLW	
1		JUN	
2		SEE PLAN	
3			
4			
5			

CONSTRUCT SANITARY SEWER MANHOLE						
ID	Sanitary Sta.	Dia.	Details	Northing	Easting	V.F.
7	14+26.82	54"	RIM = 1154.32 INV IN = 1135.97 (8") INV IN = 1139.53 (8") INV OUT = 1135.77 (8")	512498.18	2684882.43	18.5
8	16+06.54	54"	RIM = 1155.59 INV IN = 1136.89 (8") INV OUT = 1136.69 (8")	512421.17	2684720.13	18.9
9	17+39.82	54"	RIM = 1157.28 INV IN = 1143.90 (8") INV IN = 1137.62 (8") INV IN = 1143.90 (8") INV OUT = 1137.42 (8")	512348.40	2684608.52	19.9
10	20+35.91	54"	RIM = 1159.23 INV IN = 1145.28 (8") INV OUT = 1145.08 (8")	512161.23	2684379.24	14.1
11	21+09.82	54"	RIM = 1161.28 INV IN = 1149.24 (8") INV OUT = 1149.04 (8")	512197.94	2684315.12	12.2
12	21+94.40	54"	RIM = 1166.17 INV OUT = 1154.15 (8")	512197.92	2684230.57	12.0

6 INCH SERVICE LINE LOCATIONS						
LOT NO.	DIST. FROM PL		LENGTH L.F.	DEPTH FT.	WYE STA.	SERVICE RISER
	DIST.	PROP. CORNER				
97	15'	SE	33'	12'	20+68	
98	15'	SE	31'	12'	MH 12	
99	15'	NE	33'	12'	MH 12	
100	15'	NE	25'	12'	20+75	
129	15'	SE	29'	12'	13+20	6'
140	15'	NE	29'	12'	13+13	6'
141	15'	NE	29'	12'	13+93	7'
142	15'	NE	29'	12'	14+73	7'
143	15'	NE	29'	12'	15+53	7'


NO REFERENCE NOTES

RN 1 Construct 8" Diameter Drop Connection, 7.0 VF

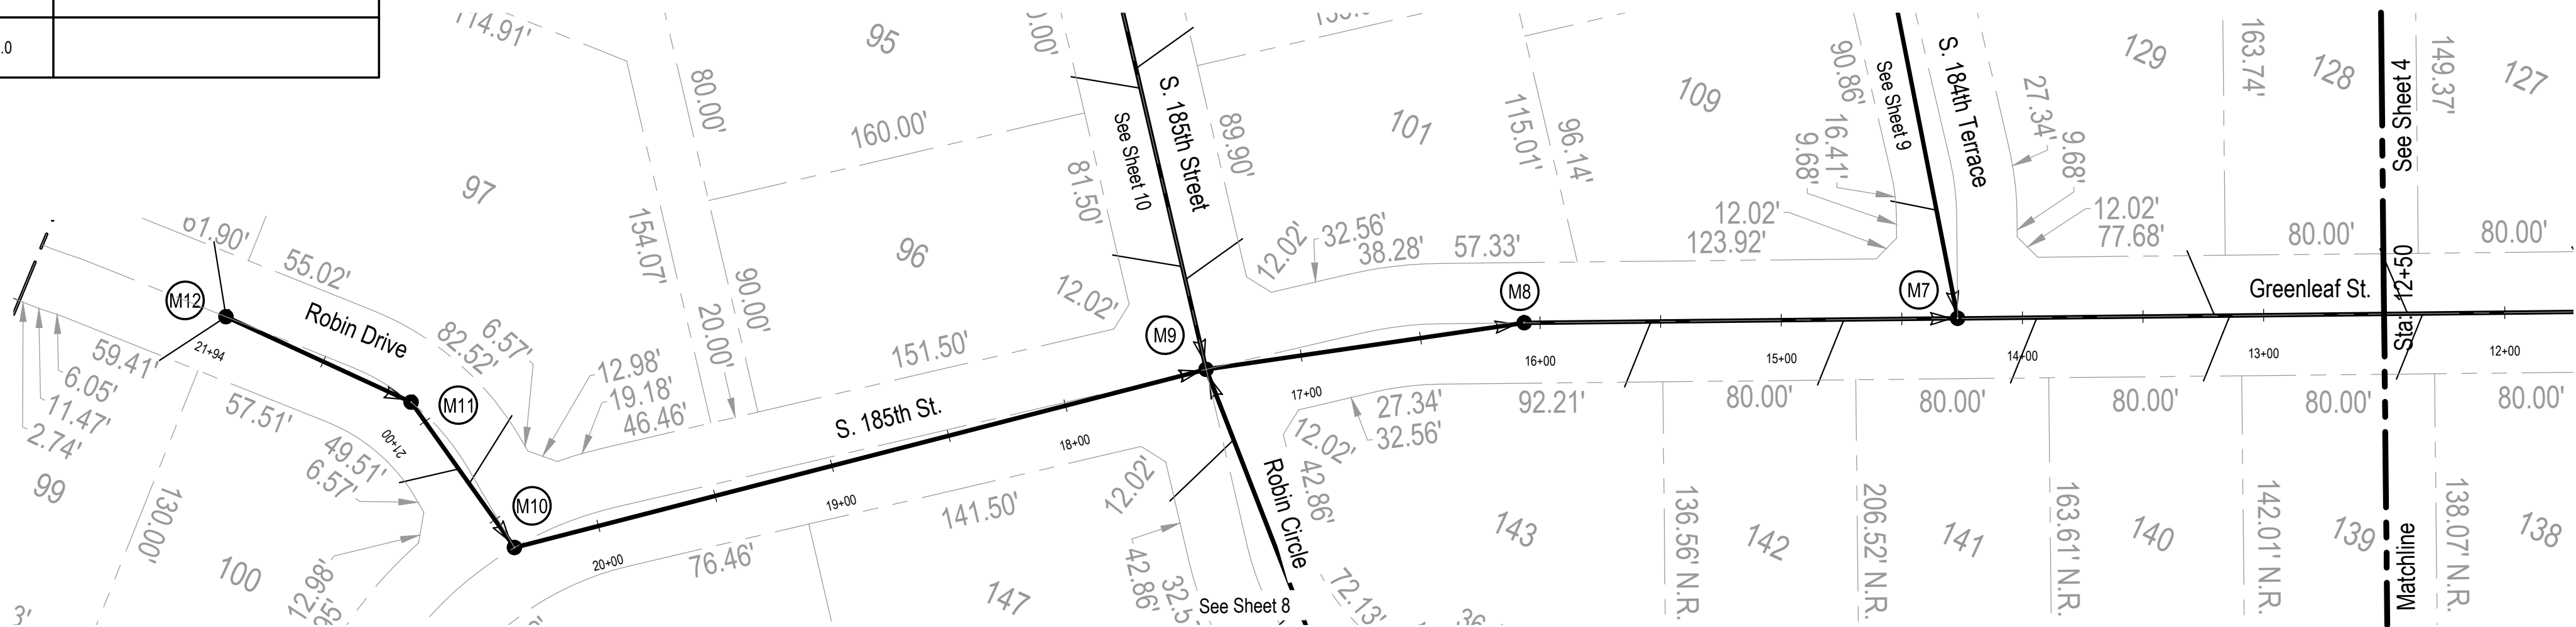

185TH STREET & GREENLEAF STREET

Scale: Horiz. 1"=50'
Vert. 1"=5'

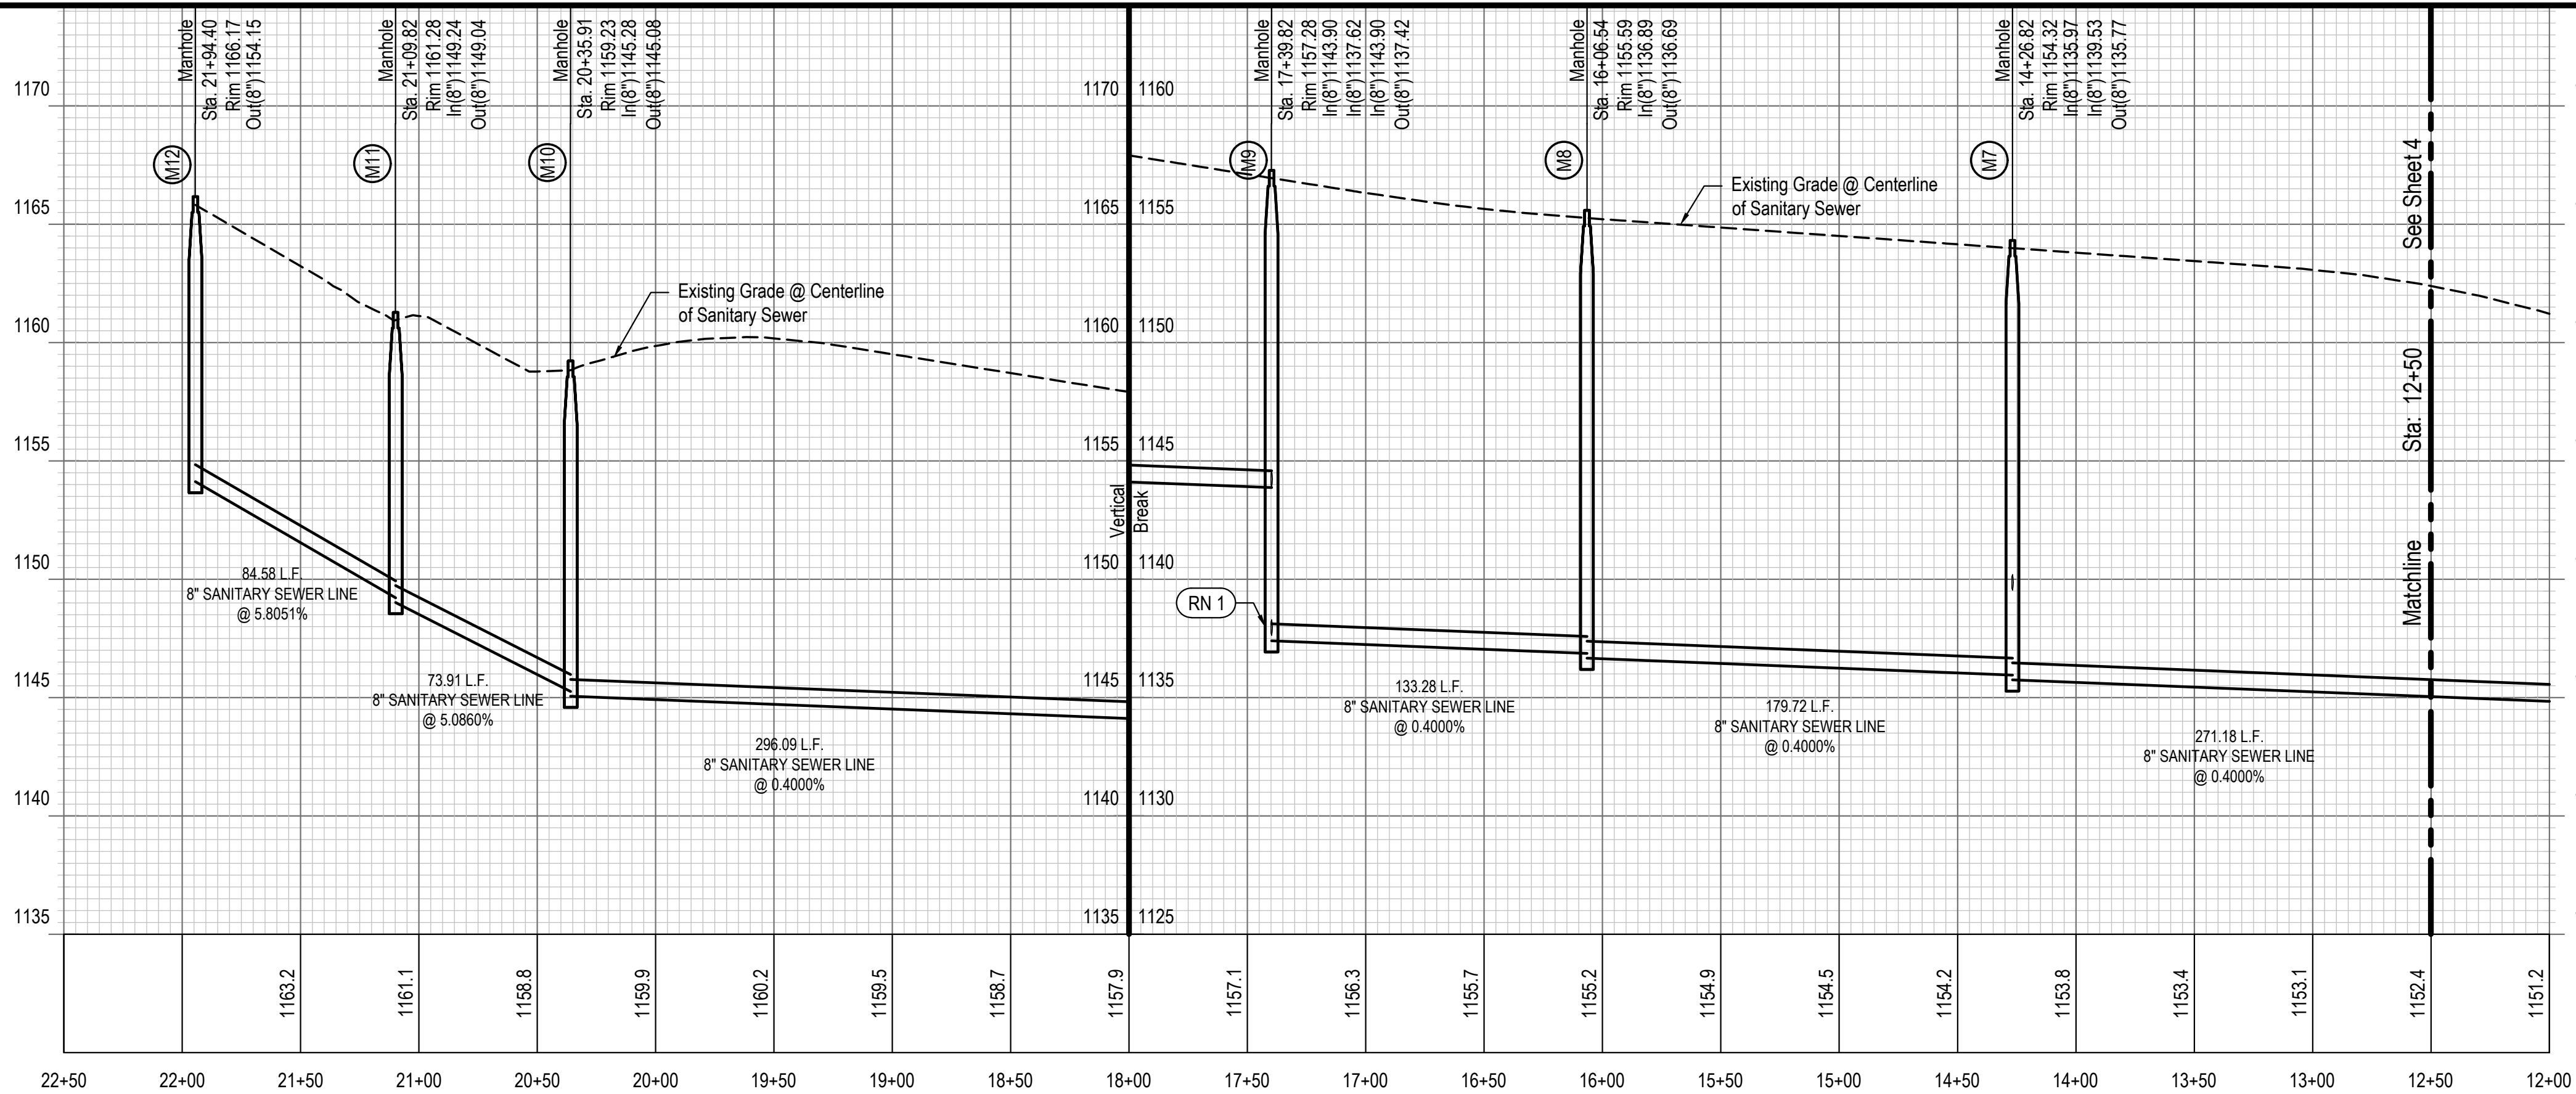

ne1call.com

Nebraska811

know what's below.
Call before you dig.

Dial: 811

RECORD DRAWINGS

THESE PLANS HAVE BEEN REVISED TO
CONFORM TO CONSTRUCTION RECORDS

REVISION DATE: 6/19/2018 BY: HLB

CHECKED BY: RP

CONTRACTOR: Kersten Construction, Inc.

E & A CONSULTING GROUP, INC.

E & A CONSULTING GROUP, INC.
Engineering • Planning • Environmental & Field Services




GARDEN OAKS
LOTS 1 THRU 147 INCLUSIVE &
OUTLOTS "A" THRU "D"
SARPY COUNTY, NEBRASKA

185TH & GREENLEAF
STREET SANITARY
SEWER PLAN & PROFILE




Revisions	
Description	Date
As-Built	6/19/2018
0	

Proj No: P2015487-001	Drawn By: JLV
Date: 10/20/2016	Scale: SEE PLAN
Designed By: JLV	Sheet: 5 of 17

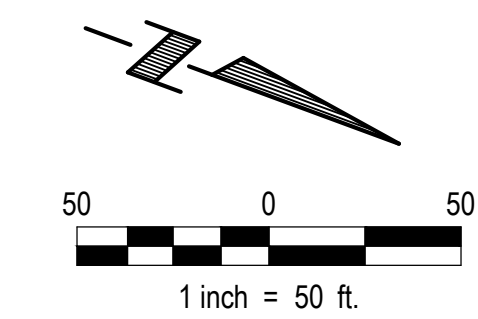


6 INCH SERVICE LINE LOCATIONS					
LOT NO.	DIST. FROM PL		LENGTH L.F.	DEPTH FT.	WYE STA.
	DIST.	PROP. CORNER			
55	15'	SW	31'	12'	0+37
56	15'	SW	33'	12'	1+62
57	15'	SE	33'	12'	MH 25
58	15'	SE	26'	12'	1+37
59	19'	SE	28'	12'	0+42

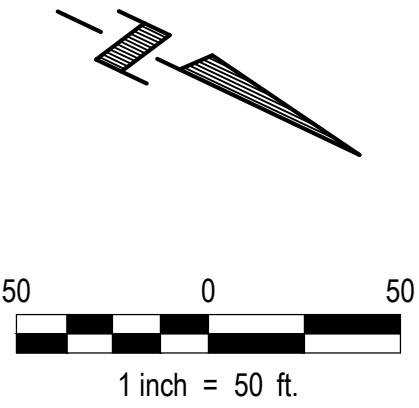


6 INCH SERVICE LINE LOCATIONS					
LOT NO.	DIST. FROM PL		LENGTH L.F.	DEPTH FT.	WYE STA.
	DIST.	PROP. CORNER			
60	21'	SW	29'	12'	0+43
61	15'	SW	28'	12'	MH 26
67	15'	SE	31'	12'	MH 26
68	15'	SE	29'	12'	0+37

CONSTRUCT SANITARY SEWER MANHOLE							
ID	Sanitary Sta.	Dia.	Details	Northing	Easting	V.F.	Remarks
26	1+22.62	54"	RIM = 1167.07 INV OUT = 1154.94 (8')	513063.86	2685042.51	12.1	

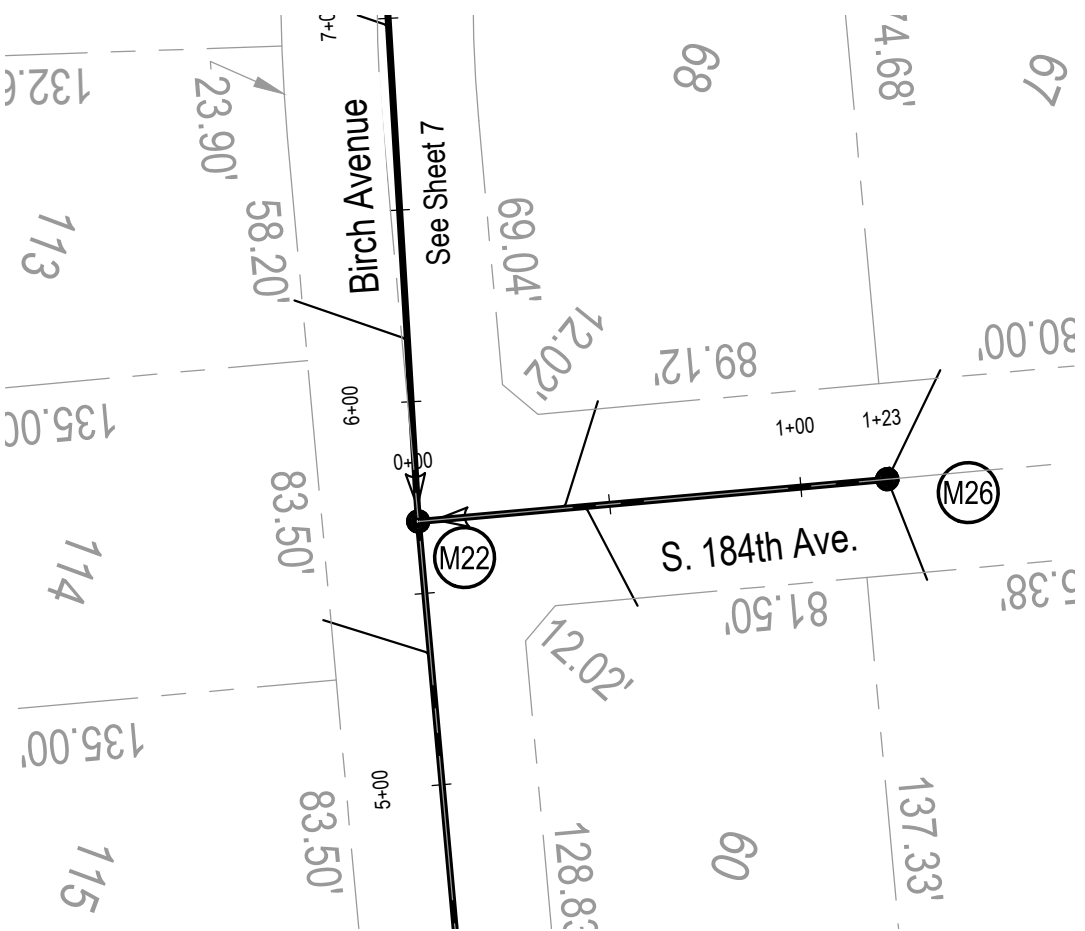


SOUTH 184TH AVENUE

6 INCH SERVICE LINE LOCATIONS					
LOT NO.	DIST. FROM PL		LENGTH L.F.	DEPTH FT.	WYE STA.
	DIST.	PROP. CORNER			
144	15'	NW	53'	8.5'	MH 37
145	15'	NW	33'	12'	1+53
146	15'	NW	38'	12'	1+05
147	15'	NW	37'	12'	0+31
					4'

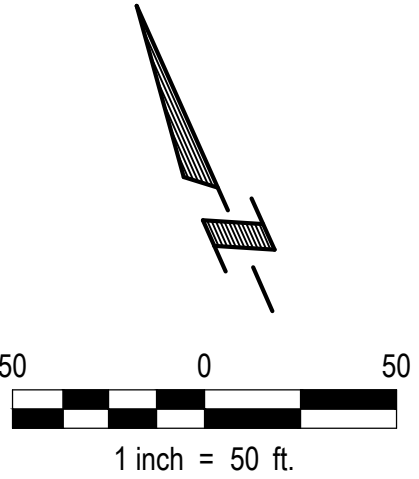


CONSTRUCT SANITARY SEWER MANHOLE							
ID	Sanitary Sta.	Dia.	Details	Northing	Easting	V.F.	Remarks
36	1+36.95	54"	RIM = 1152.00 INV IN = 1138.37 (8') INV OUT = 1138.17 (8')	512253.42	2684707.10	13.8	
37	2+25.22	54"	RIM = 1148.70 INV OUT = 1138.99 (8')	512252.73	2684795.34	9.7	


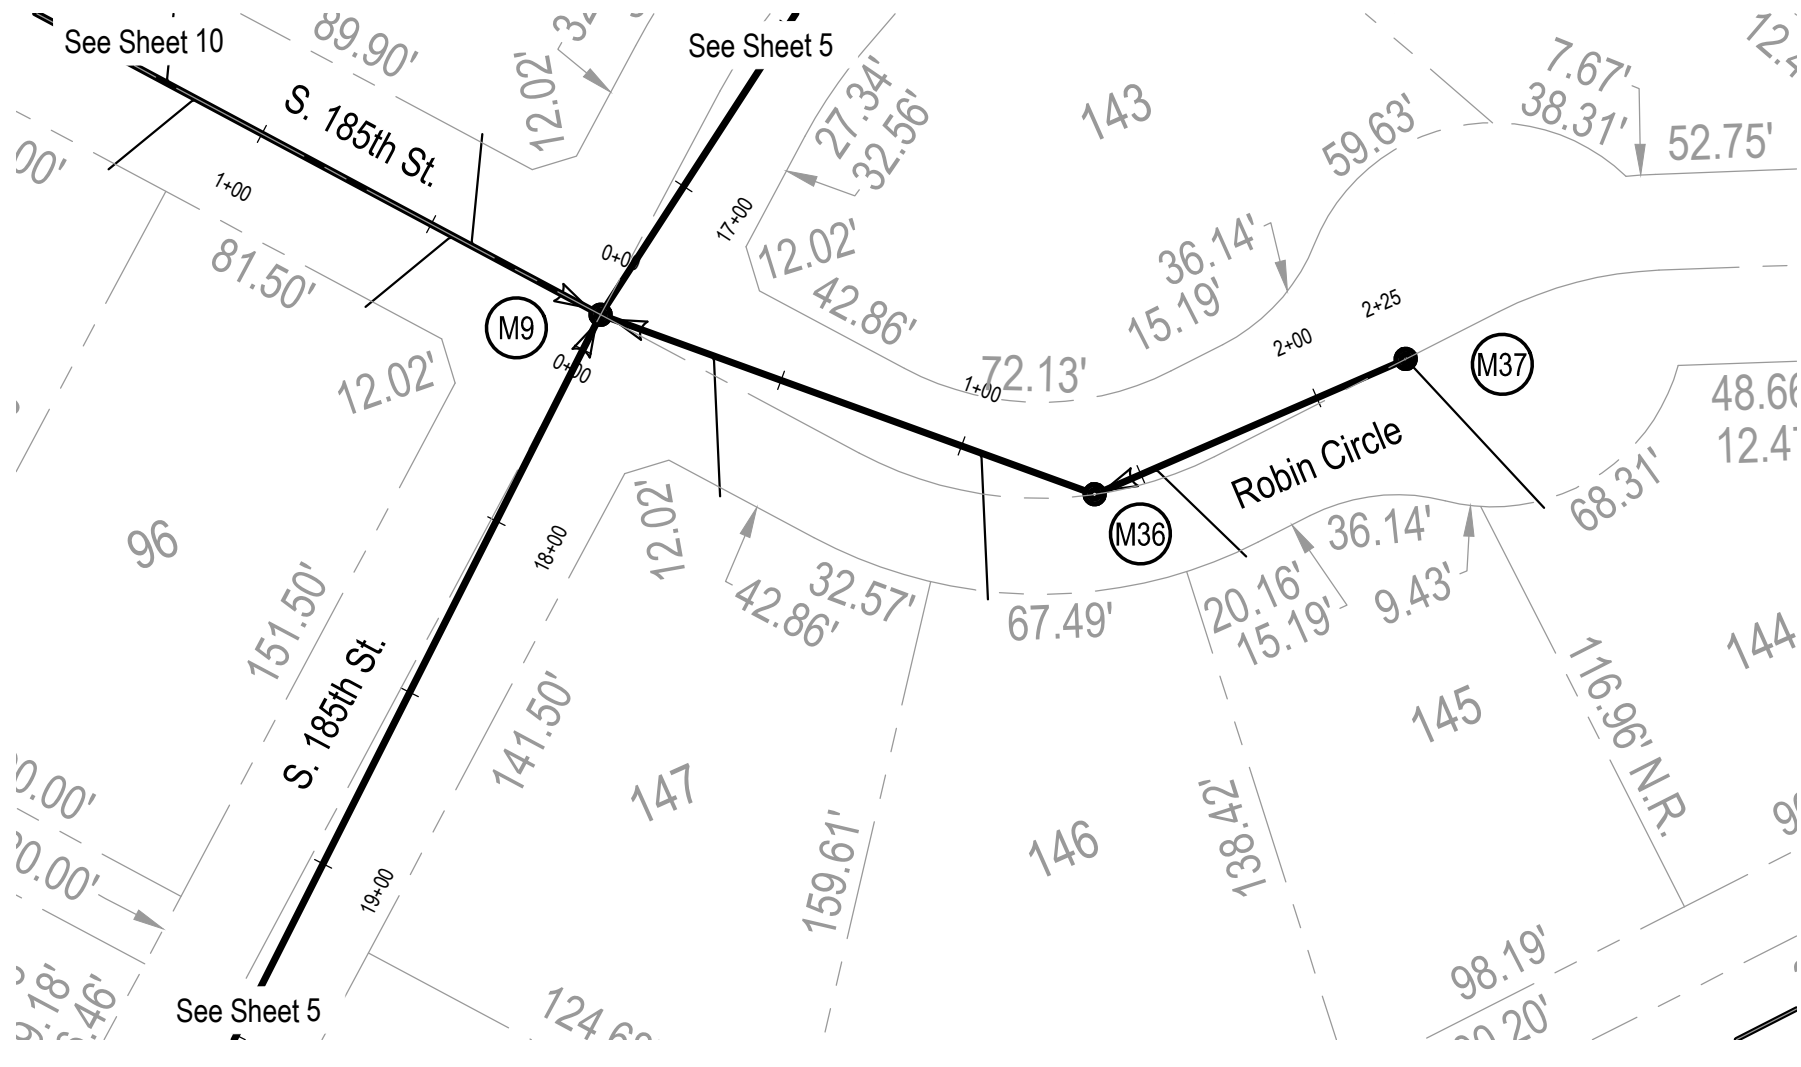


Scale: Horiz. 1"=50'
Vert. 1"=5'

CONSTRUCT SANITARY SEWER MANHOLE							
ID	Sanitary Sta.	Dia.	Details	Northing	Easting	V.F.	Remarks
25	2+25.31	54"	RIM = 1149.38 INV OUT = 1135.67 (8')	513293.69	2685287.54	13.7	

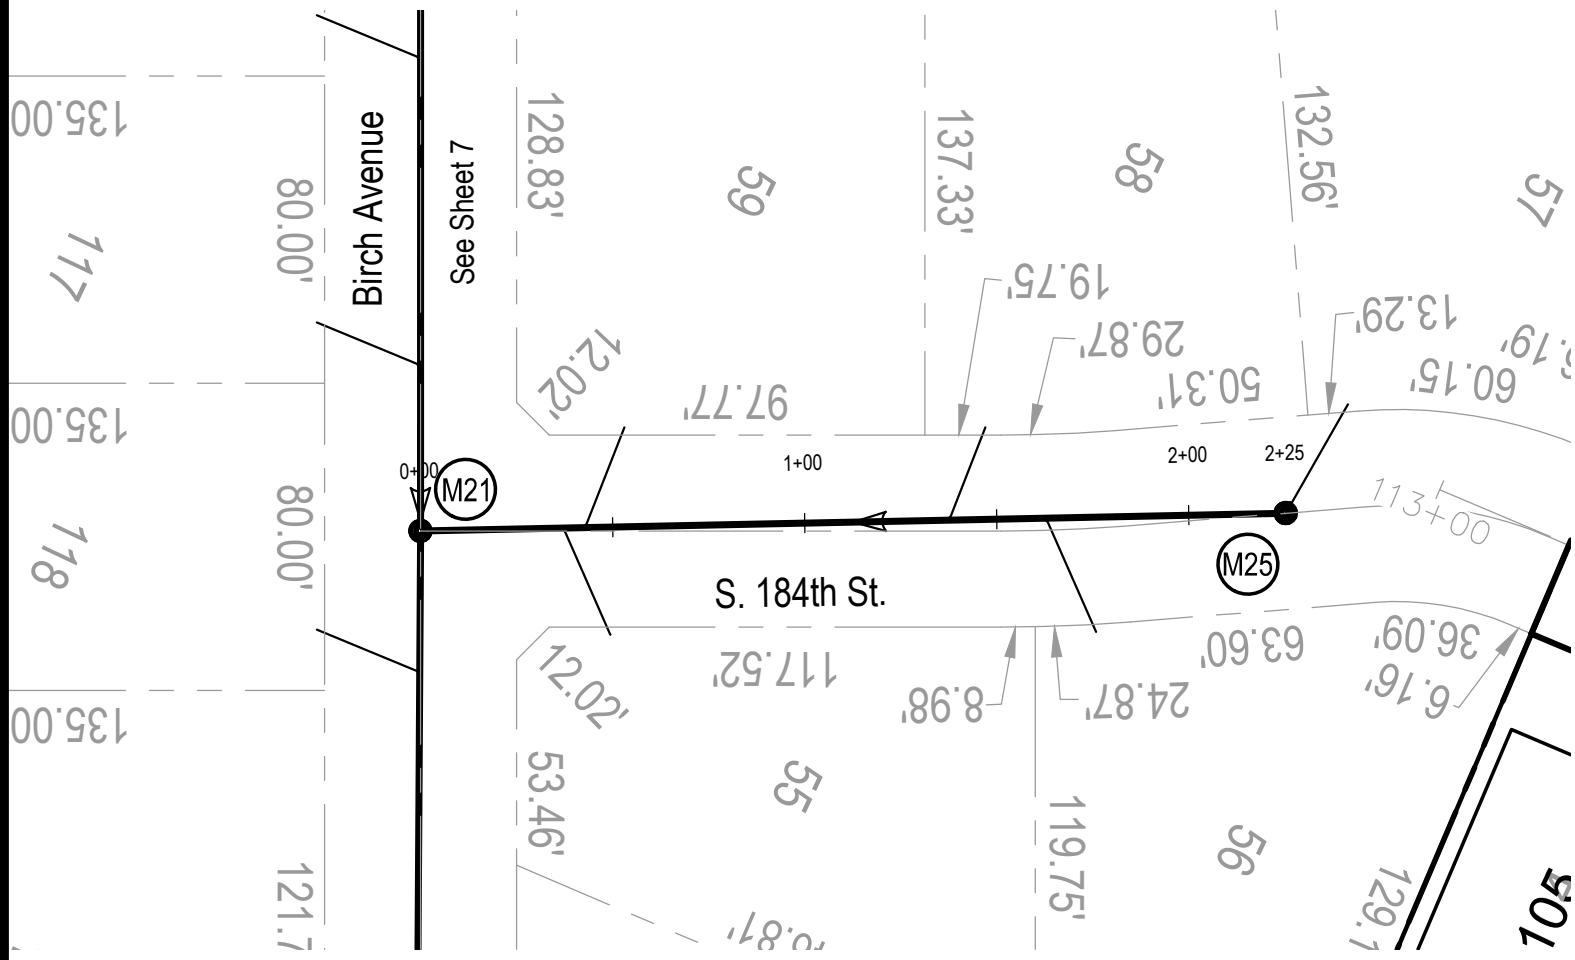

SOUTH 184TH STREET

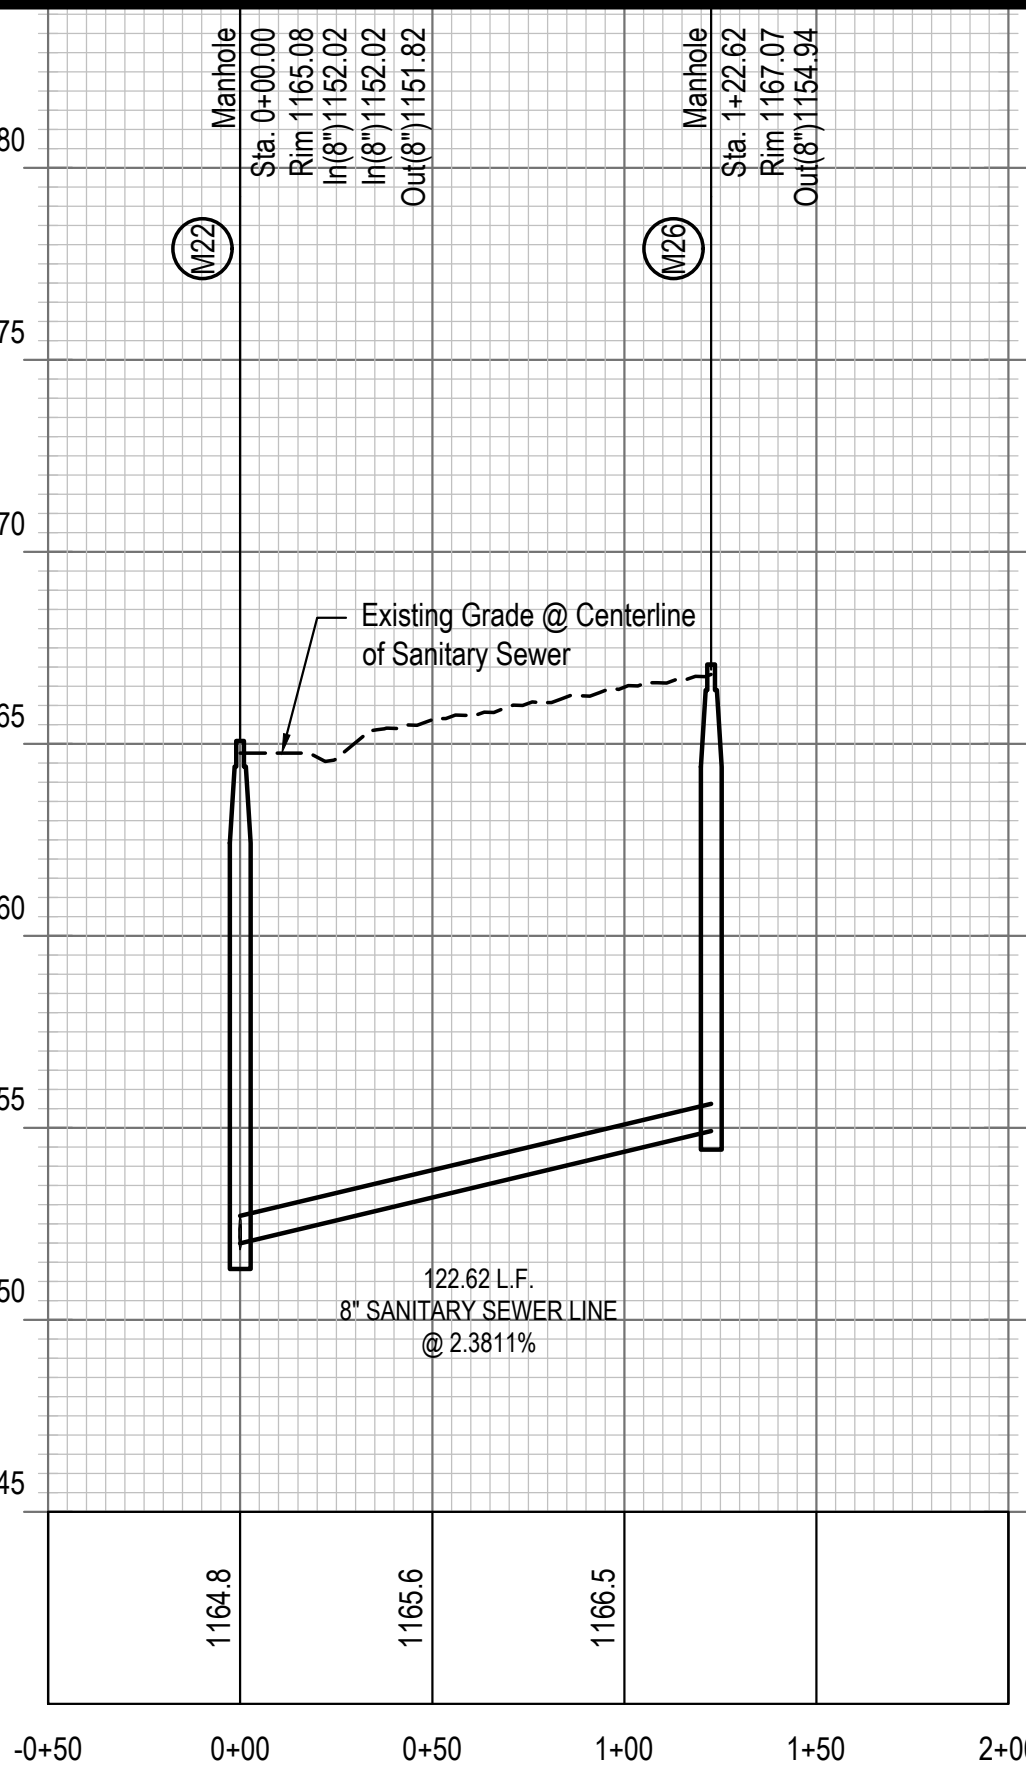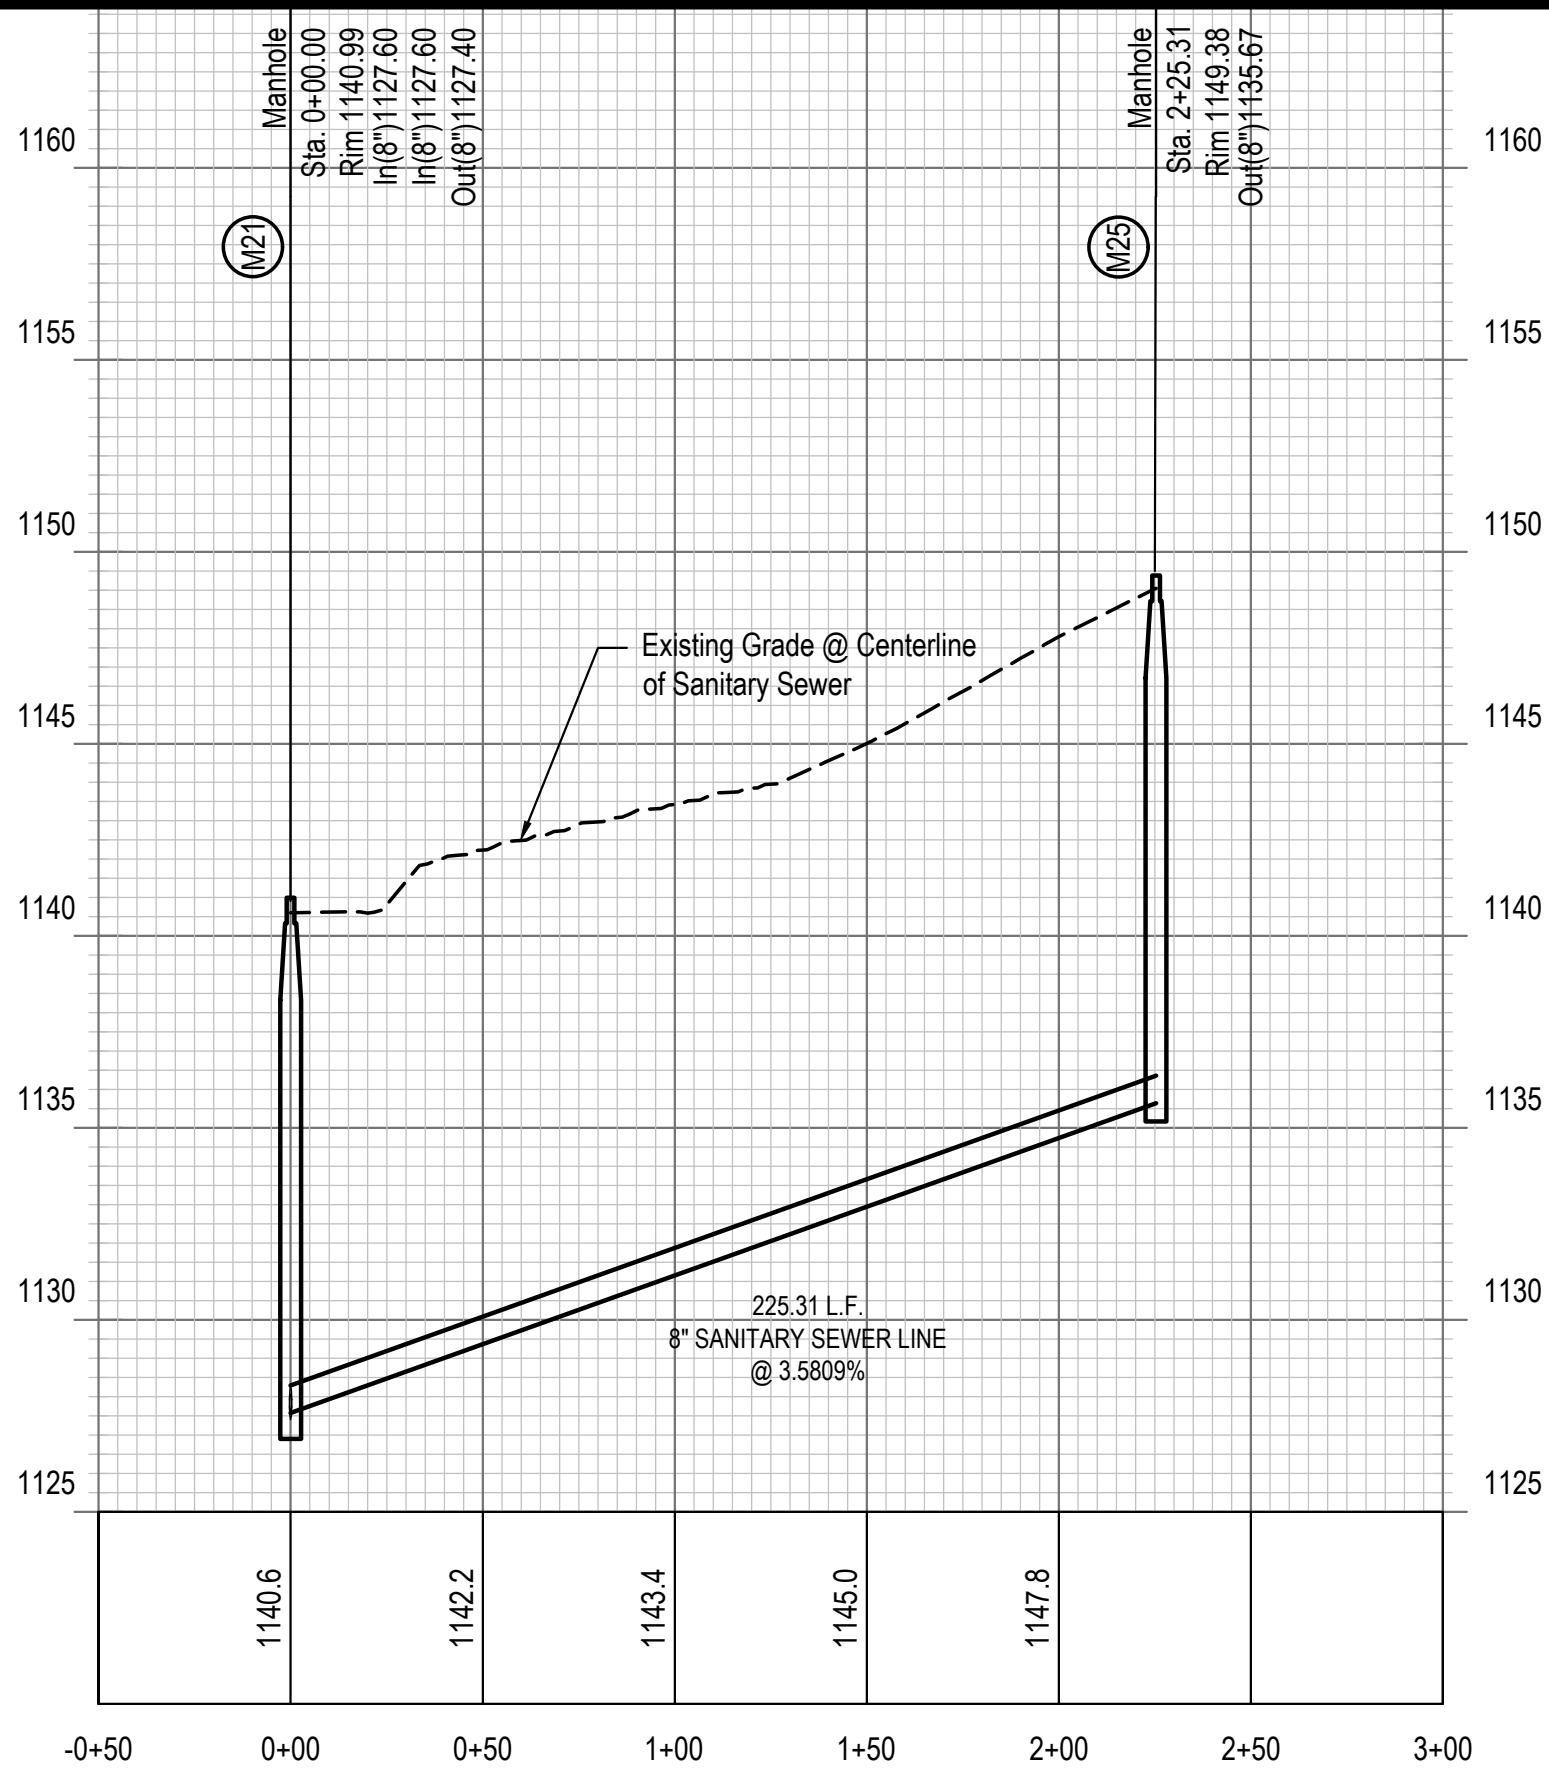



RECORD DRAWINGS
THESE PLANS HAVE BEEN REVISED TO
CONFORM TO CONSTRUCTION RECORDS

REVISION DATE: 6/19/2018 BY: HLB

CHECKED BY: *RP*

CONTRACTOR: Kersten Construction, Inc.

E & A CONSULTING GROUP, INC.

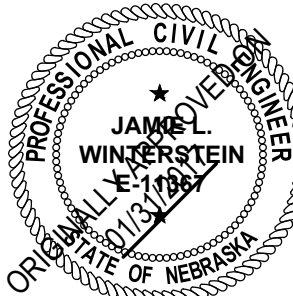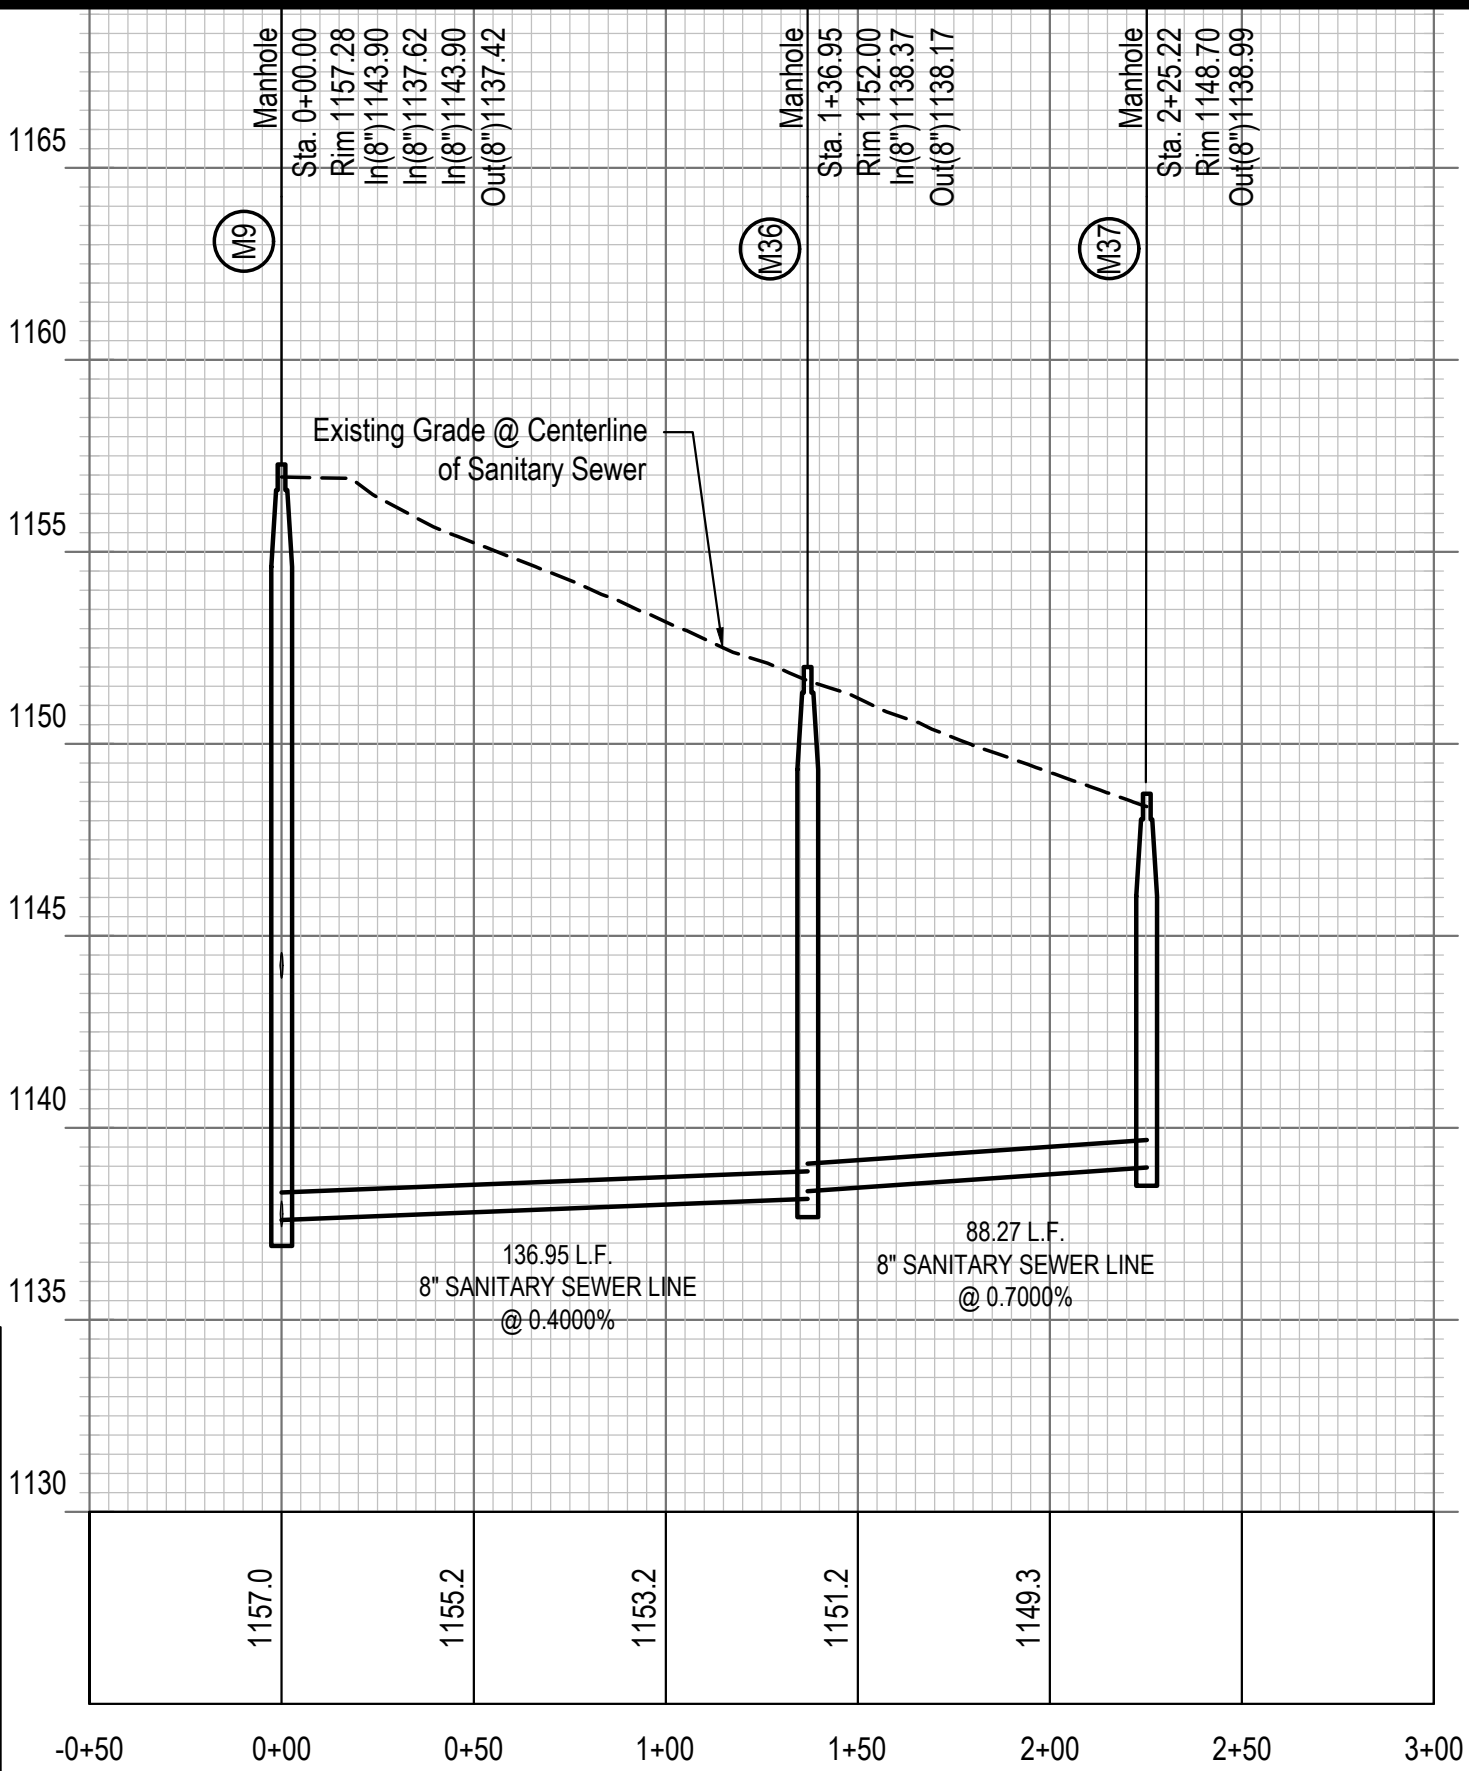



Revisions		Date	
No.	Description	Date	As-Built
0		6/19/2018	
Designed By: JLW		JUN	
Drawn By: SEE PLAN		Scale: .8 of .17	
Sheet: 8 of 17		Proj No: P2015487.001	

6 INCH SERVICE LINE LOCATIONS					
LOT NO.	DIST. FROM PL		LENGTH L.F.	DEPTH FT.	WYE STA.
	DIST.	PROP. CORNER			
69	21'	SW	30'	12'	4+76
70	15'	SW	28'	12'	MH 30
77	15'	SE	31'	12'	MH 30
78	15'	SE	29'	12'	4+70
106	15'	SE	30'	12'	MH 28
107	15'	SE	27'	12'	2+51
108	15'	SE	23'	12'	1+61
109	15'	SE	20'	12'	0+45

CONSTRUCT SANITARY SEWER MANHOLE						
ID	Sanitary Sta.	Dia.	Details	Northing	Eastng	V.F.
28	3+38.32	54"	RIM = 1173.56 INV IN = 1161.56 (8") INV OUT = 1161.36 (8")	512772.14	2684684.14	12.2
29	4+58.00	54"	RIM = 1178.52 INV IN = 1166.52 (8") INV OUT = 1166.32 (8")	512888.26	2684655.31	12.2
30	5+55.38	54"	RIM = 1179.72 INV OUT = 1167.72 (8")	512985.52	2684651.31	12.0


NO REFERENCE NOTES

RN 1 Construct 8" Diameter Drop Connection, 7.0 VF

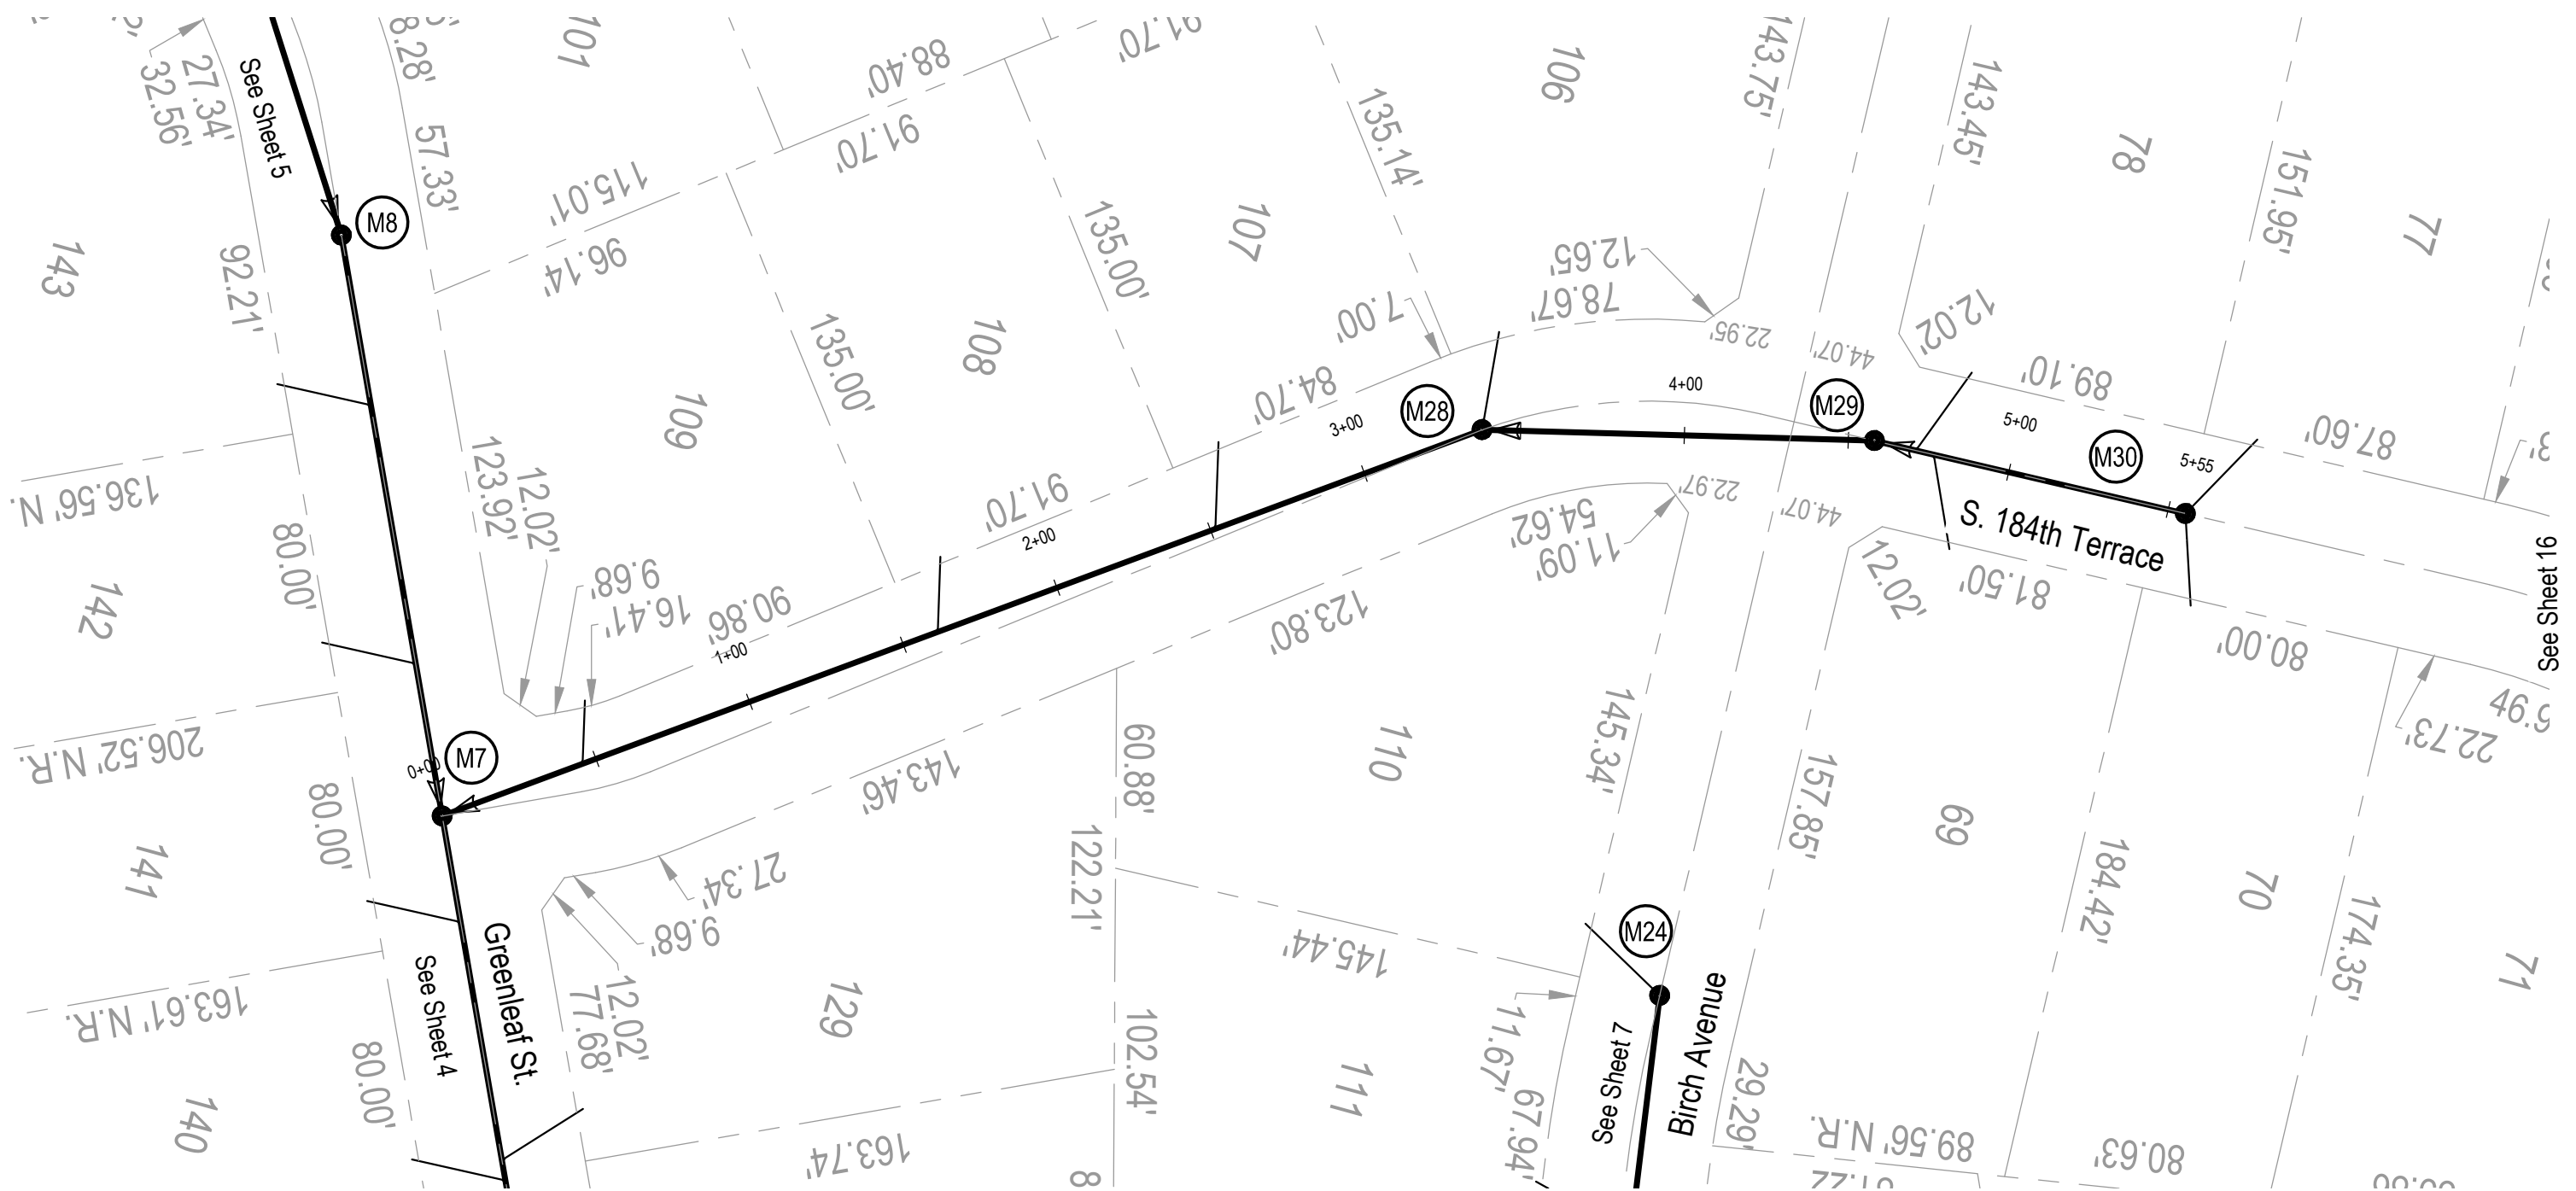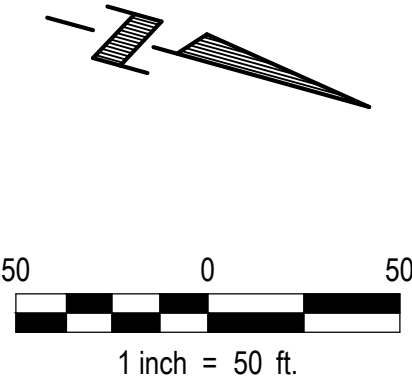

SOUTH 184TH TERRACE

Scale: Horiz. 1"=50'
Vert. 1"=5'

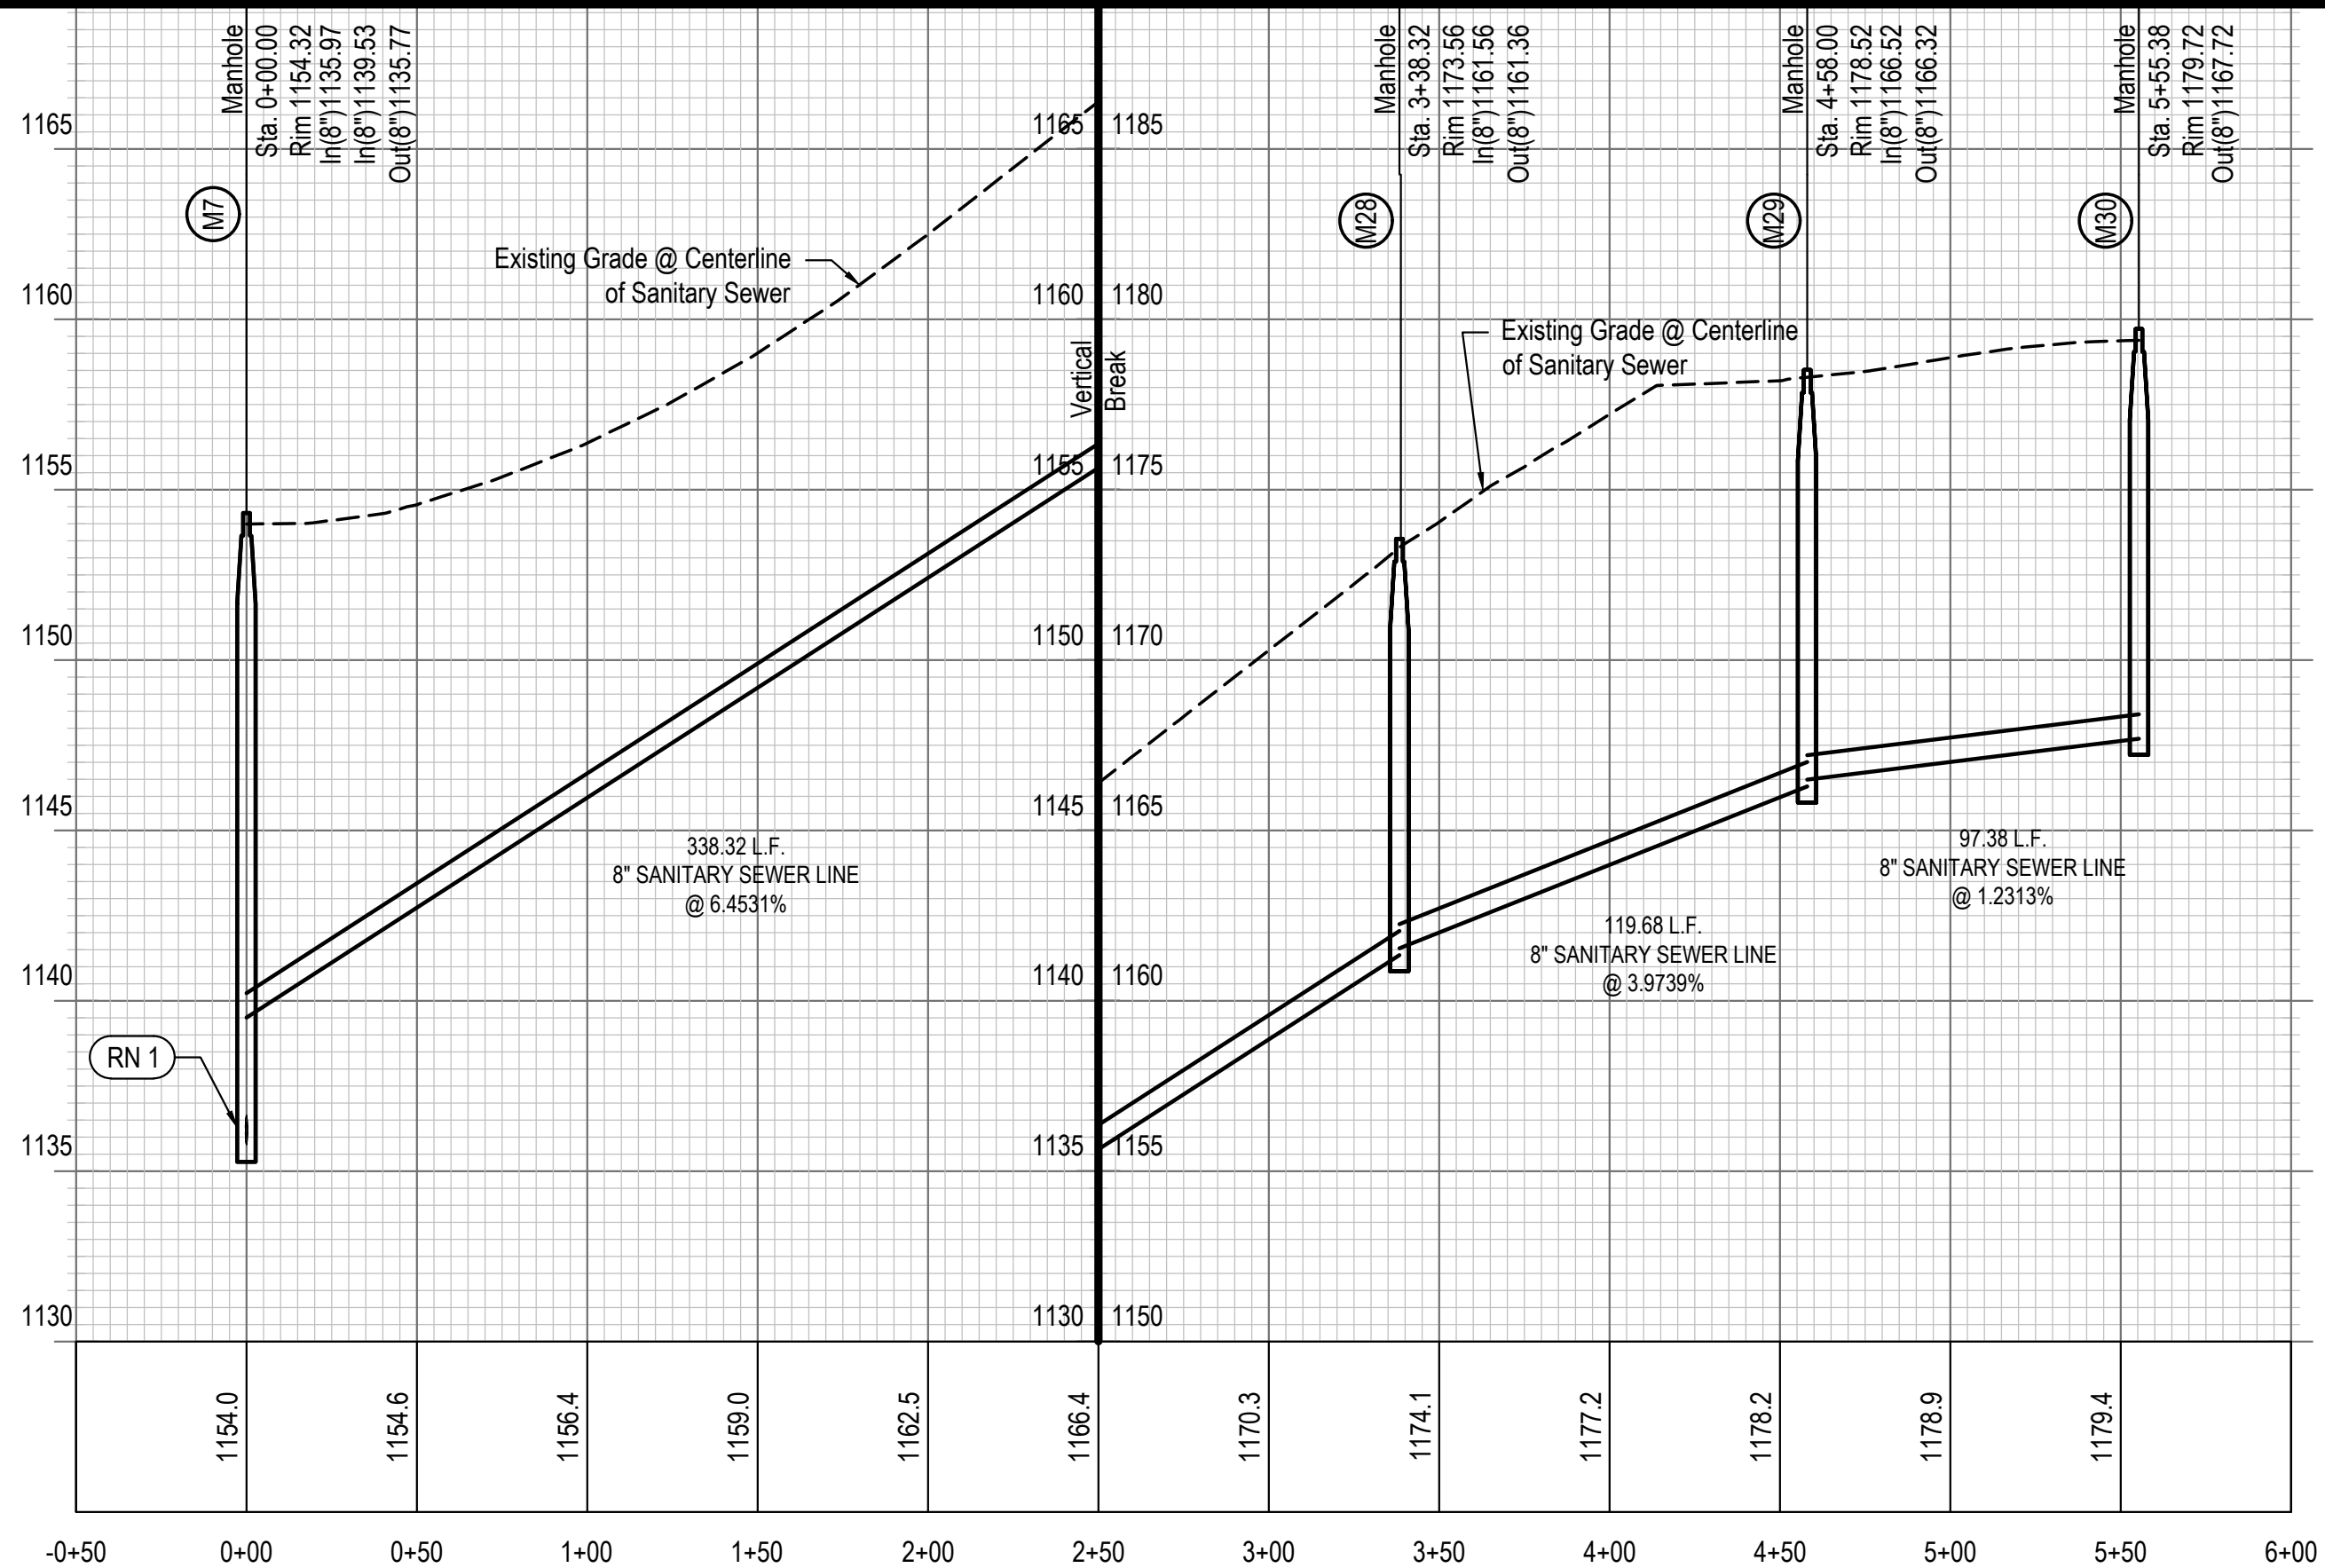

RECORD DRAWINGS


THESE PLANS HAVE BEEN REVISED TO
CONFORM TO CONSTRUCTION RECORDS

REVISION DATE: 6/19/2018 BY: HLB

CHECKED BY: RP


CONTRACTOR: Kersten Construction, Inc.

E & A CONSULTING GROUP, INC.

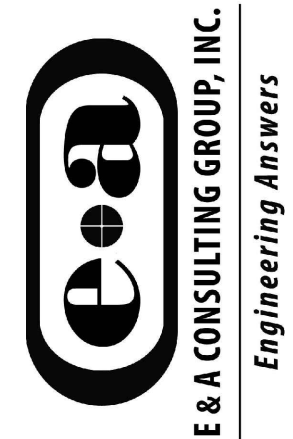

GARDEN OAKS
LOTS 1 THRU 147 INCLUSIVE &
OUTLOTS "A" THRU "D"
SARPY COUNTY, NEBRASKA

S 184th TERRACE
SANITARY SEWER PLAN
& PROFILE

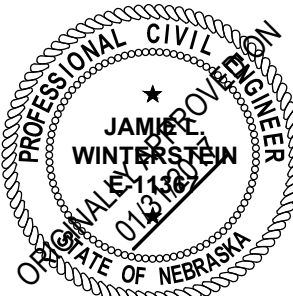


Revisions		As-Built	
Date	Description	Date	Description
10/20/2016	JLW	6/19/2018	JLW
			JUN
			SEE PLAN
			Scale: 9 of 17
			Sheet: 9 of 17

6 INCH SERVICE LINE LOCATIONS					
LOT NO.	DIST. FROM PL		LENGTH L.F.	DEPTH FT.	WYE STA.
	DIST.	PROP. CORNER			
79	15'	SW	27'	12'	6+39
80	15'	SW	28'	12'	7+28
81	15'	SW	26'	12'	8+21
82	15'	SW	54'	12'	9+02
83	15'	SW	52'	12'	MH 35
84	15'	SE	52'	12'	MH 35

6 INCH SERVICE LINE LOCATIONS					
LOT NO.	DIST. FROM PL		LENGTH L.F.	DEPTH FT.	WYE STA.
	DIST.	PROP. CORNER			
85	15'	SE	48'	12'	8+74
86	15'	SE	28'	12'	MH 34
87	20'	SE	31'	12'	7+33
88	15'	SE	32'	12'	6+47
89	15'	SE	33'	12'	5+67
90	15'	SE	36'	12'	MH 33

6 INCH SERVICE LINE LOCATIONS					
LOT NO.	DIST. FROM PL		LENGTH L.F.	DEPTH FT.	WYE STA.
	DIST.	PROP. CORNER			
91	15'	SE	34'	12'	4+37
92	15'	NE	32'	12'	3+58
93	15'	NE	31'	12'	MH 32
94	15'	NE	29'	12'	1+99
95	15'	NE	29'	12'	1+19
96	21'	NE	29'	12'	0+43

6 INCH SERVICE LINE LOCATIONS					
LOT NO.	DIST. FROM PL		LENGTH L.F.	DEPTH FT.	WYE STA.
	DIST.	PROP. CORNER			
101	15'	SW	29'	12'	0+38
102	15'	SW	29'	12'	1+27
103	15'	SW	29'	12'	2+16
104	15'	SW	28'	12'	3+05
105	15'	SW	26'	12'	3+94

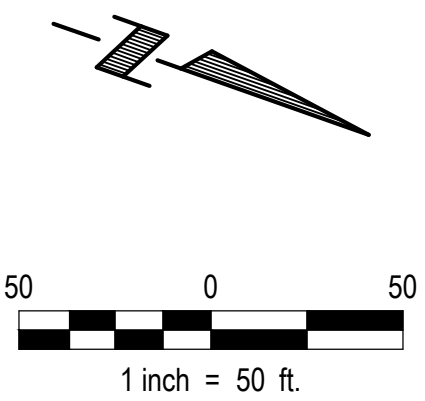


CONSTRUCT SANITARY SEWER MANHOLE						
ID	Sanitary Sta.	Dia.	Details	Northing	Easting	V.F.
32	2+75.00	54"	RIM = 1169.92 INV IN = 1158.13 (8") INV OUT = 1157.93 (8")	512565.28	2684439.59	12.0
33	4+88.47	54"	RIM = 1182.57 INV IN = 1170.77 (8") INV OUT = 1170.57 (8")	512736.52	2684312.26	12.0
34	8+11.06	54"	RIM = 1195.69 INV IN = 1183.27 (8") INV OUT = 1183.07 (8")	513058.48	2684294.24	12.6
35	9+37.49	54"	RIM = 1199.11 INV OUT = 1187.11 (8")	513183.29	2684314.13	12.0


REFERENCE NOTES

(NO)
RN 1 Construct 8" Diameter Drop Connection, 8.0 VF

ne1call.com
Nebraska 811
know what's below.
Call before you dig.
Dial: 811

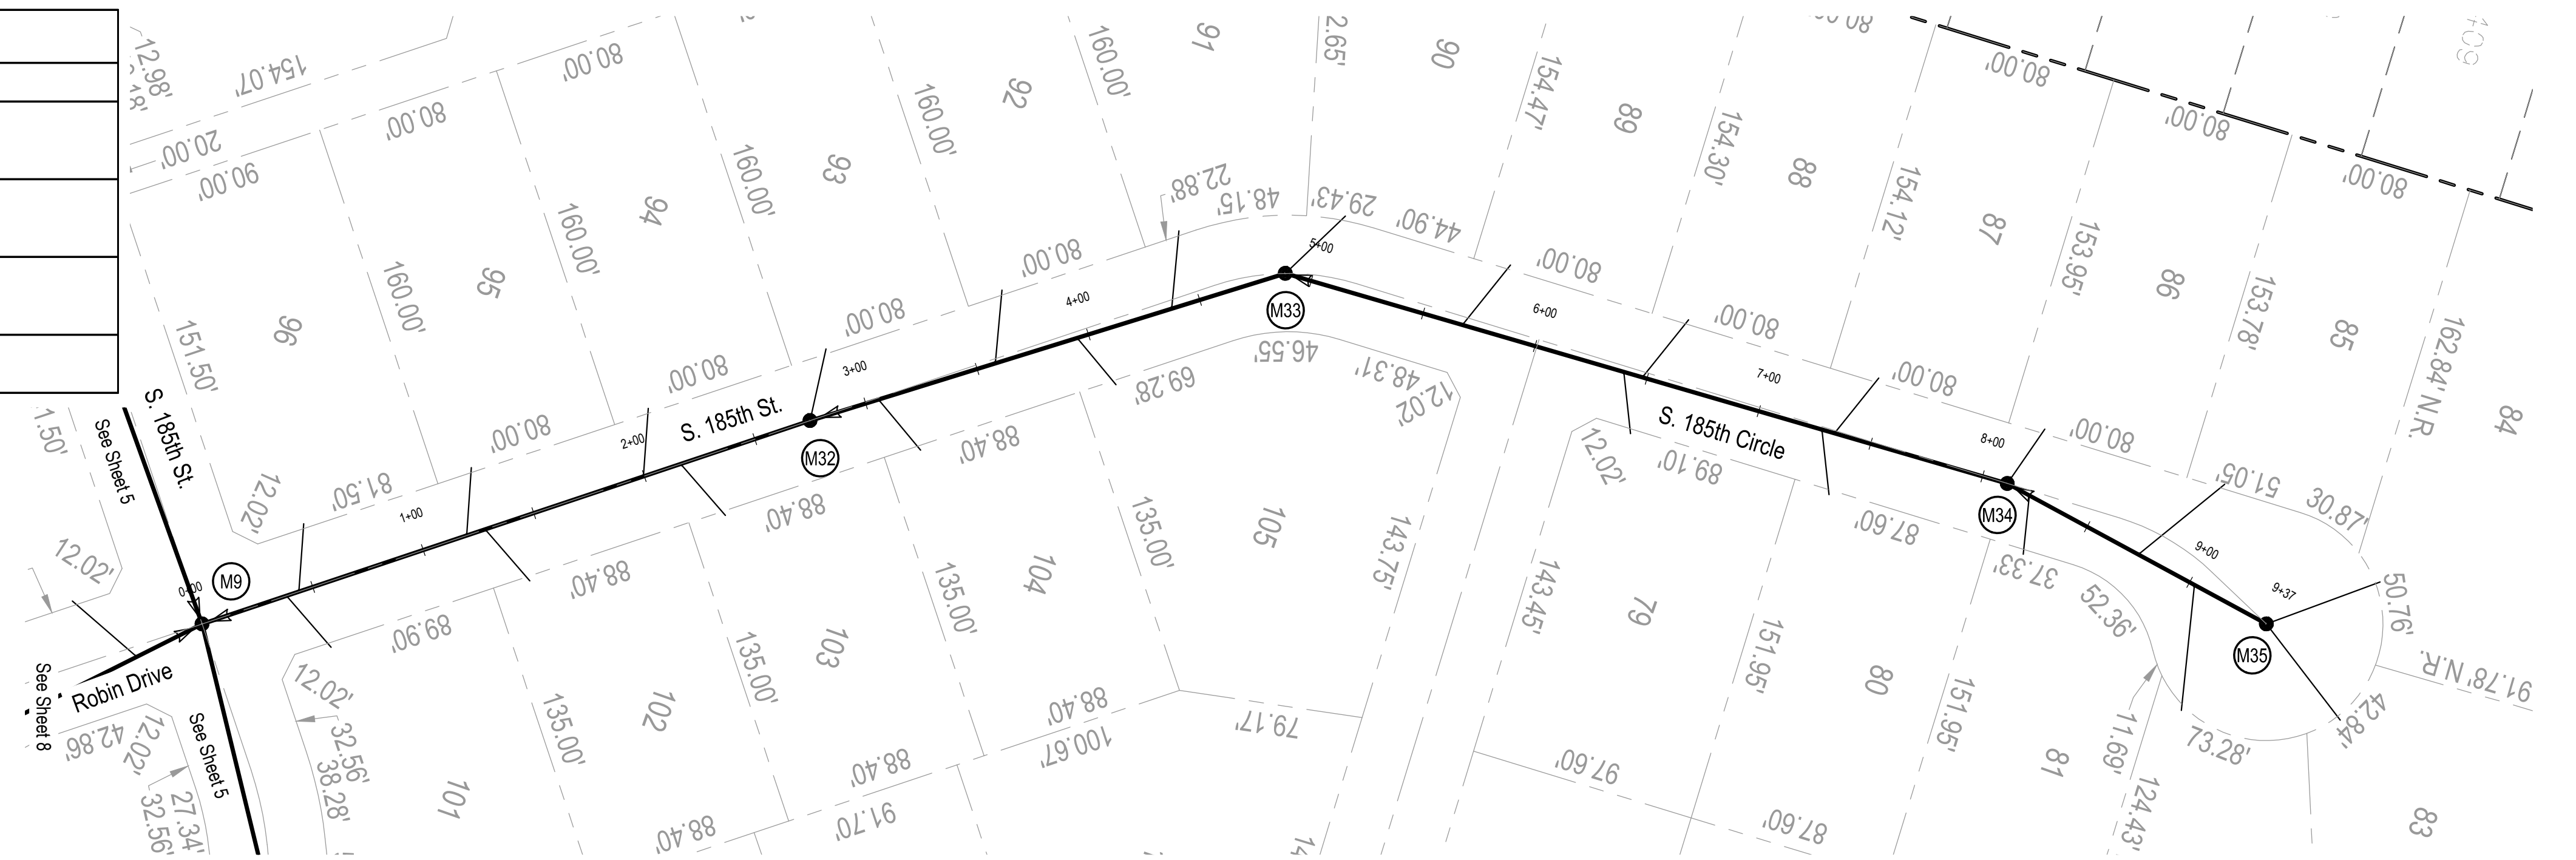

SOUTH 185TH STREET & SOUTH 185TH CIRCLE

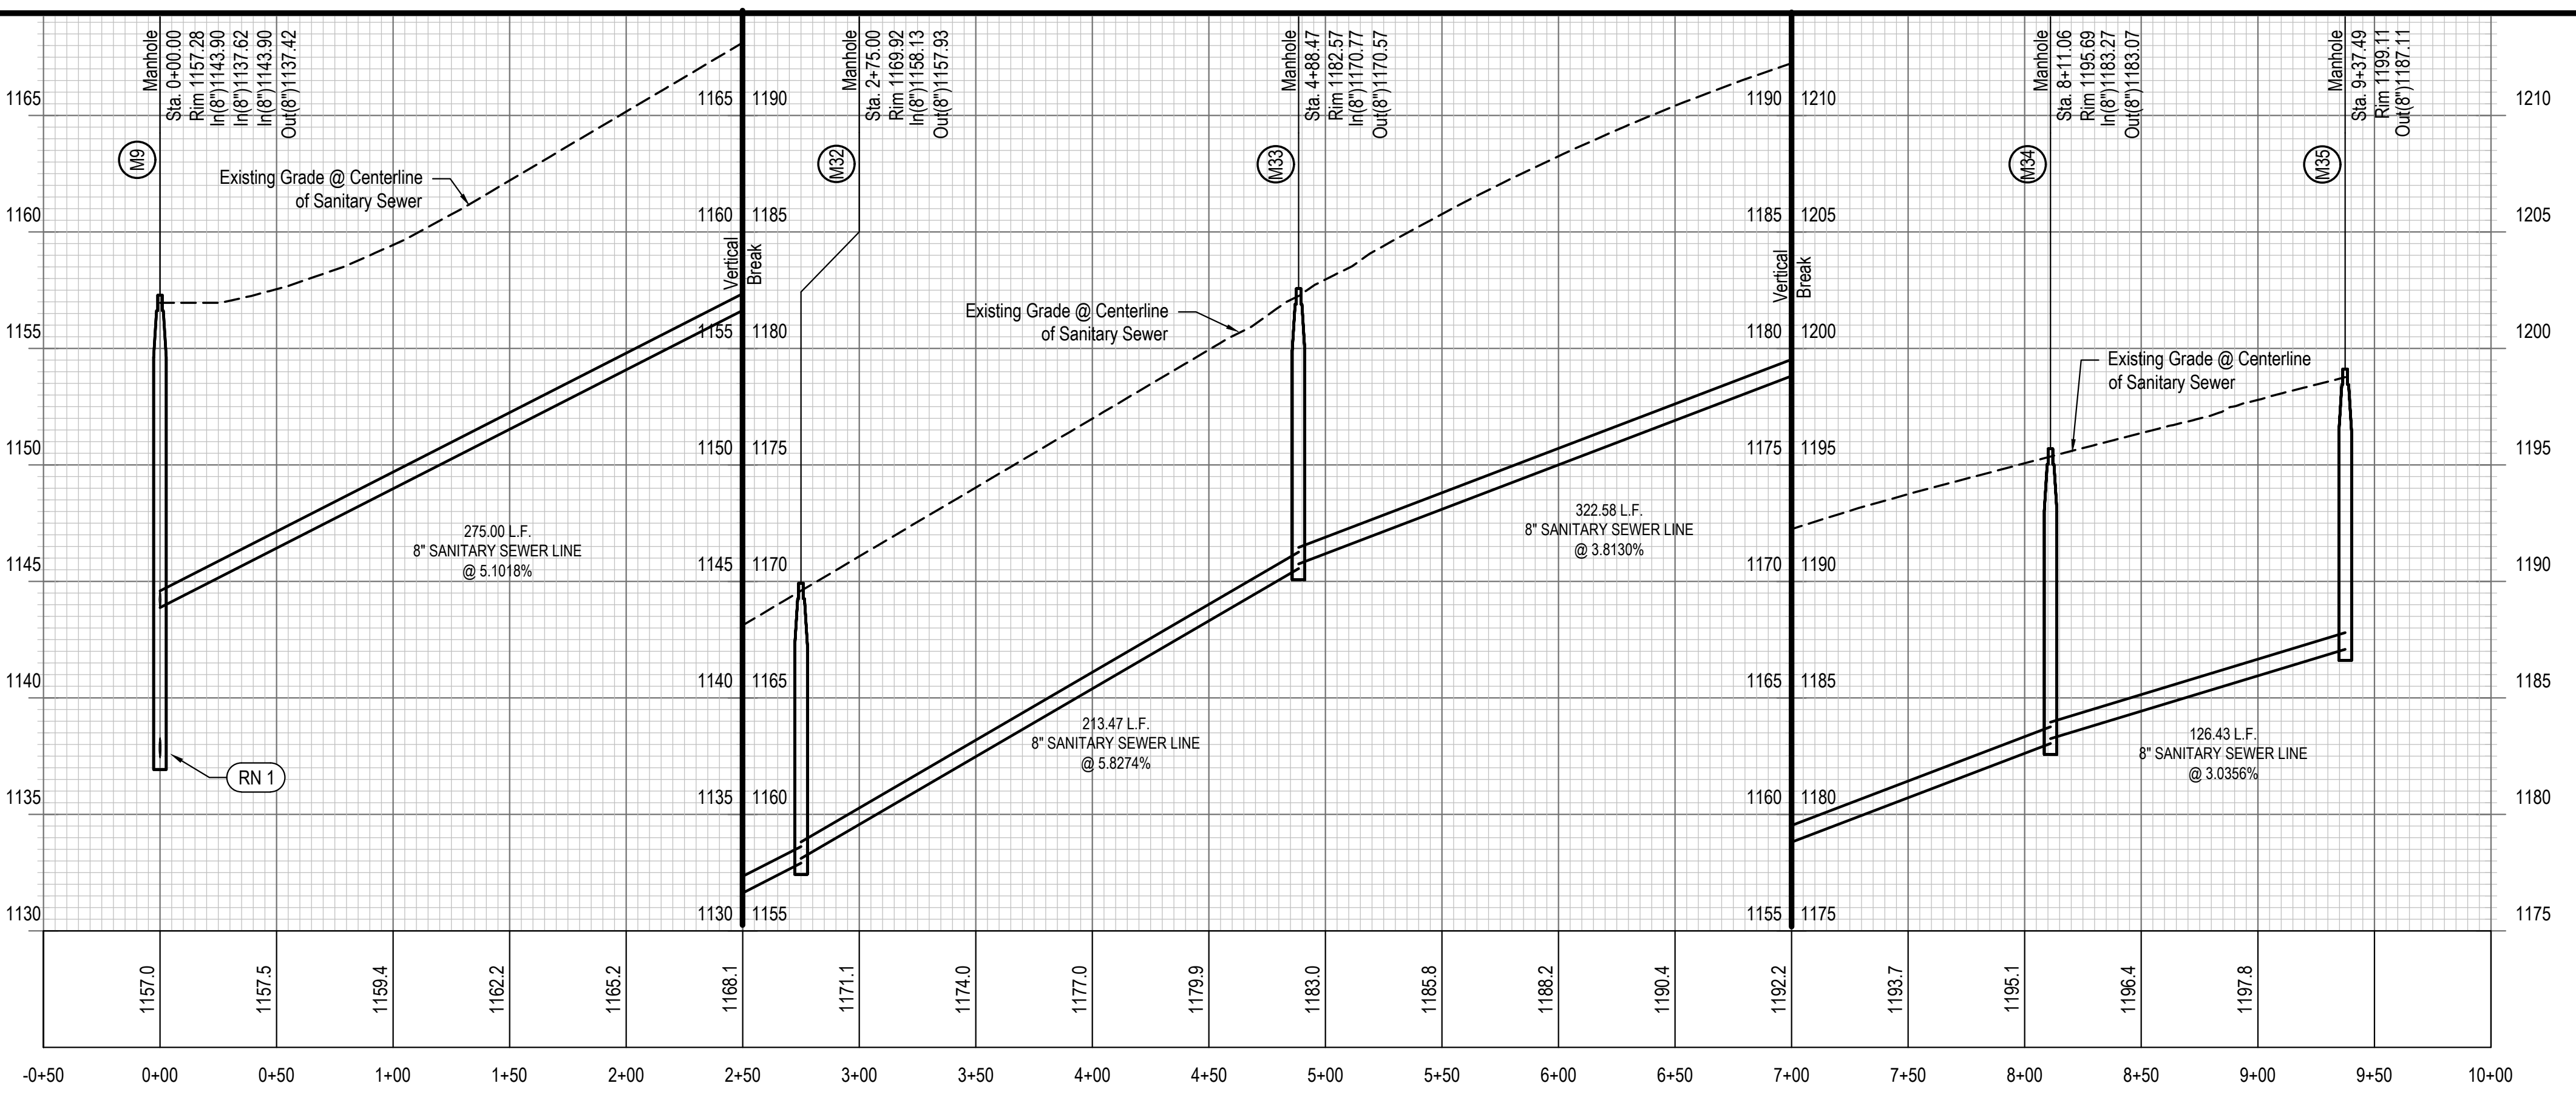

RECORD DRAWINGS

THESE PLANS HAVE BEEN REVISED TO
CONFORM TO CONSTRUCTION RECORDS


REVISION DATE: 6/19/2018 BY: HLB

CHECKED BY: *RP*

CONTRACTOR: Kersten Construction, Inc.

E & A CONSULTING GROUP, INC.

E & A CONSULTING GROUP, INC.
Engineering • Planning • Environmental & Field Services

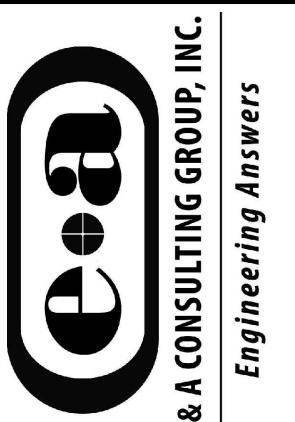

GARDEN OAKS
LOTS 1 THRU 147 INCLUSIVE &
OUTLOTS "A" THRU "D"
SARPY COUNTY, NEBRASKA

S 185th ST & S 185th
CIRCLE SANITARY
SEWER PLAN & PROFILE




Revisions		Date	
No.	Description		
0	As-Built	6/19/2018	
Designed By: JLV		Drawn By: JLV	
Scale: SEE PLAN		Sheet: 10 of 17	

6 INCH SERVICE LINE LOCATIONS					
LOT NO.	DIST. FROM PL		LENGTH L.F.	DEPTH FT.	WYE STA.
	DIST.	PROP. CORNER			
5	15'	SE	25'	12'	6+14
6	15'	SW	38'	12'	MH 55
7	15'	SW	34'	12'	6+06
8	15'	SW	34'	12'	MH 53
9	15'	SW	31'	12'	3+52
10	86'	NW	32'	12'	MH 10
13	18'	NW	29'	12'	1+41
14	19'	NW	29'	12'	0+41
15	15'	SW	30'	12'	0+35
16	15'	SW	30'	12'	1+35
17	15'	SE	34'	12'	MH 53

CONSTRUCT SANITARY SEWER MANHOLE							
ID	Sanitary Sta.	Dia.	Details	Northing	Easting	V.F.	Remarks
52	2+54.21	54 "	RIM = 1135.17 INV IN = 1124.29 (8") INV OUT = 1124.00 (8")	514225.05	2686474.84	11.2 12.3	INV IN = 1223.00 (8") INV OUT = 1222.80 (8")
53	4+35.95	54 "	RIM = 1147.02 INV IN = 1135.02 (8") INV OUT = 1134.82 (8")	514405.02	2686450.04	12.2	
54	5+68.81	54 "	RIM = 1154.68 INV IN = 1140.33 (8") INV OUT = 1140.13 (8")	514517.94	2686380.13	14.5	
55	7+11.13	54 "	RIM = 1160.75 INV OUT = 1147.75 (8")	514635.98	2686459.56	13.0	


REFERENCE NOTES

NO
RN 1 Connect to Stub

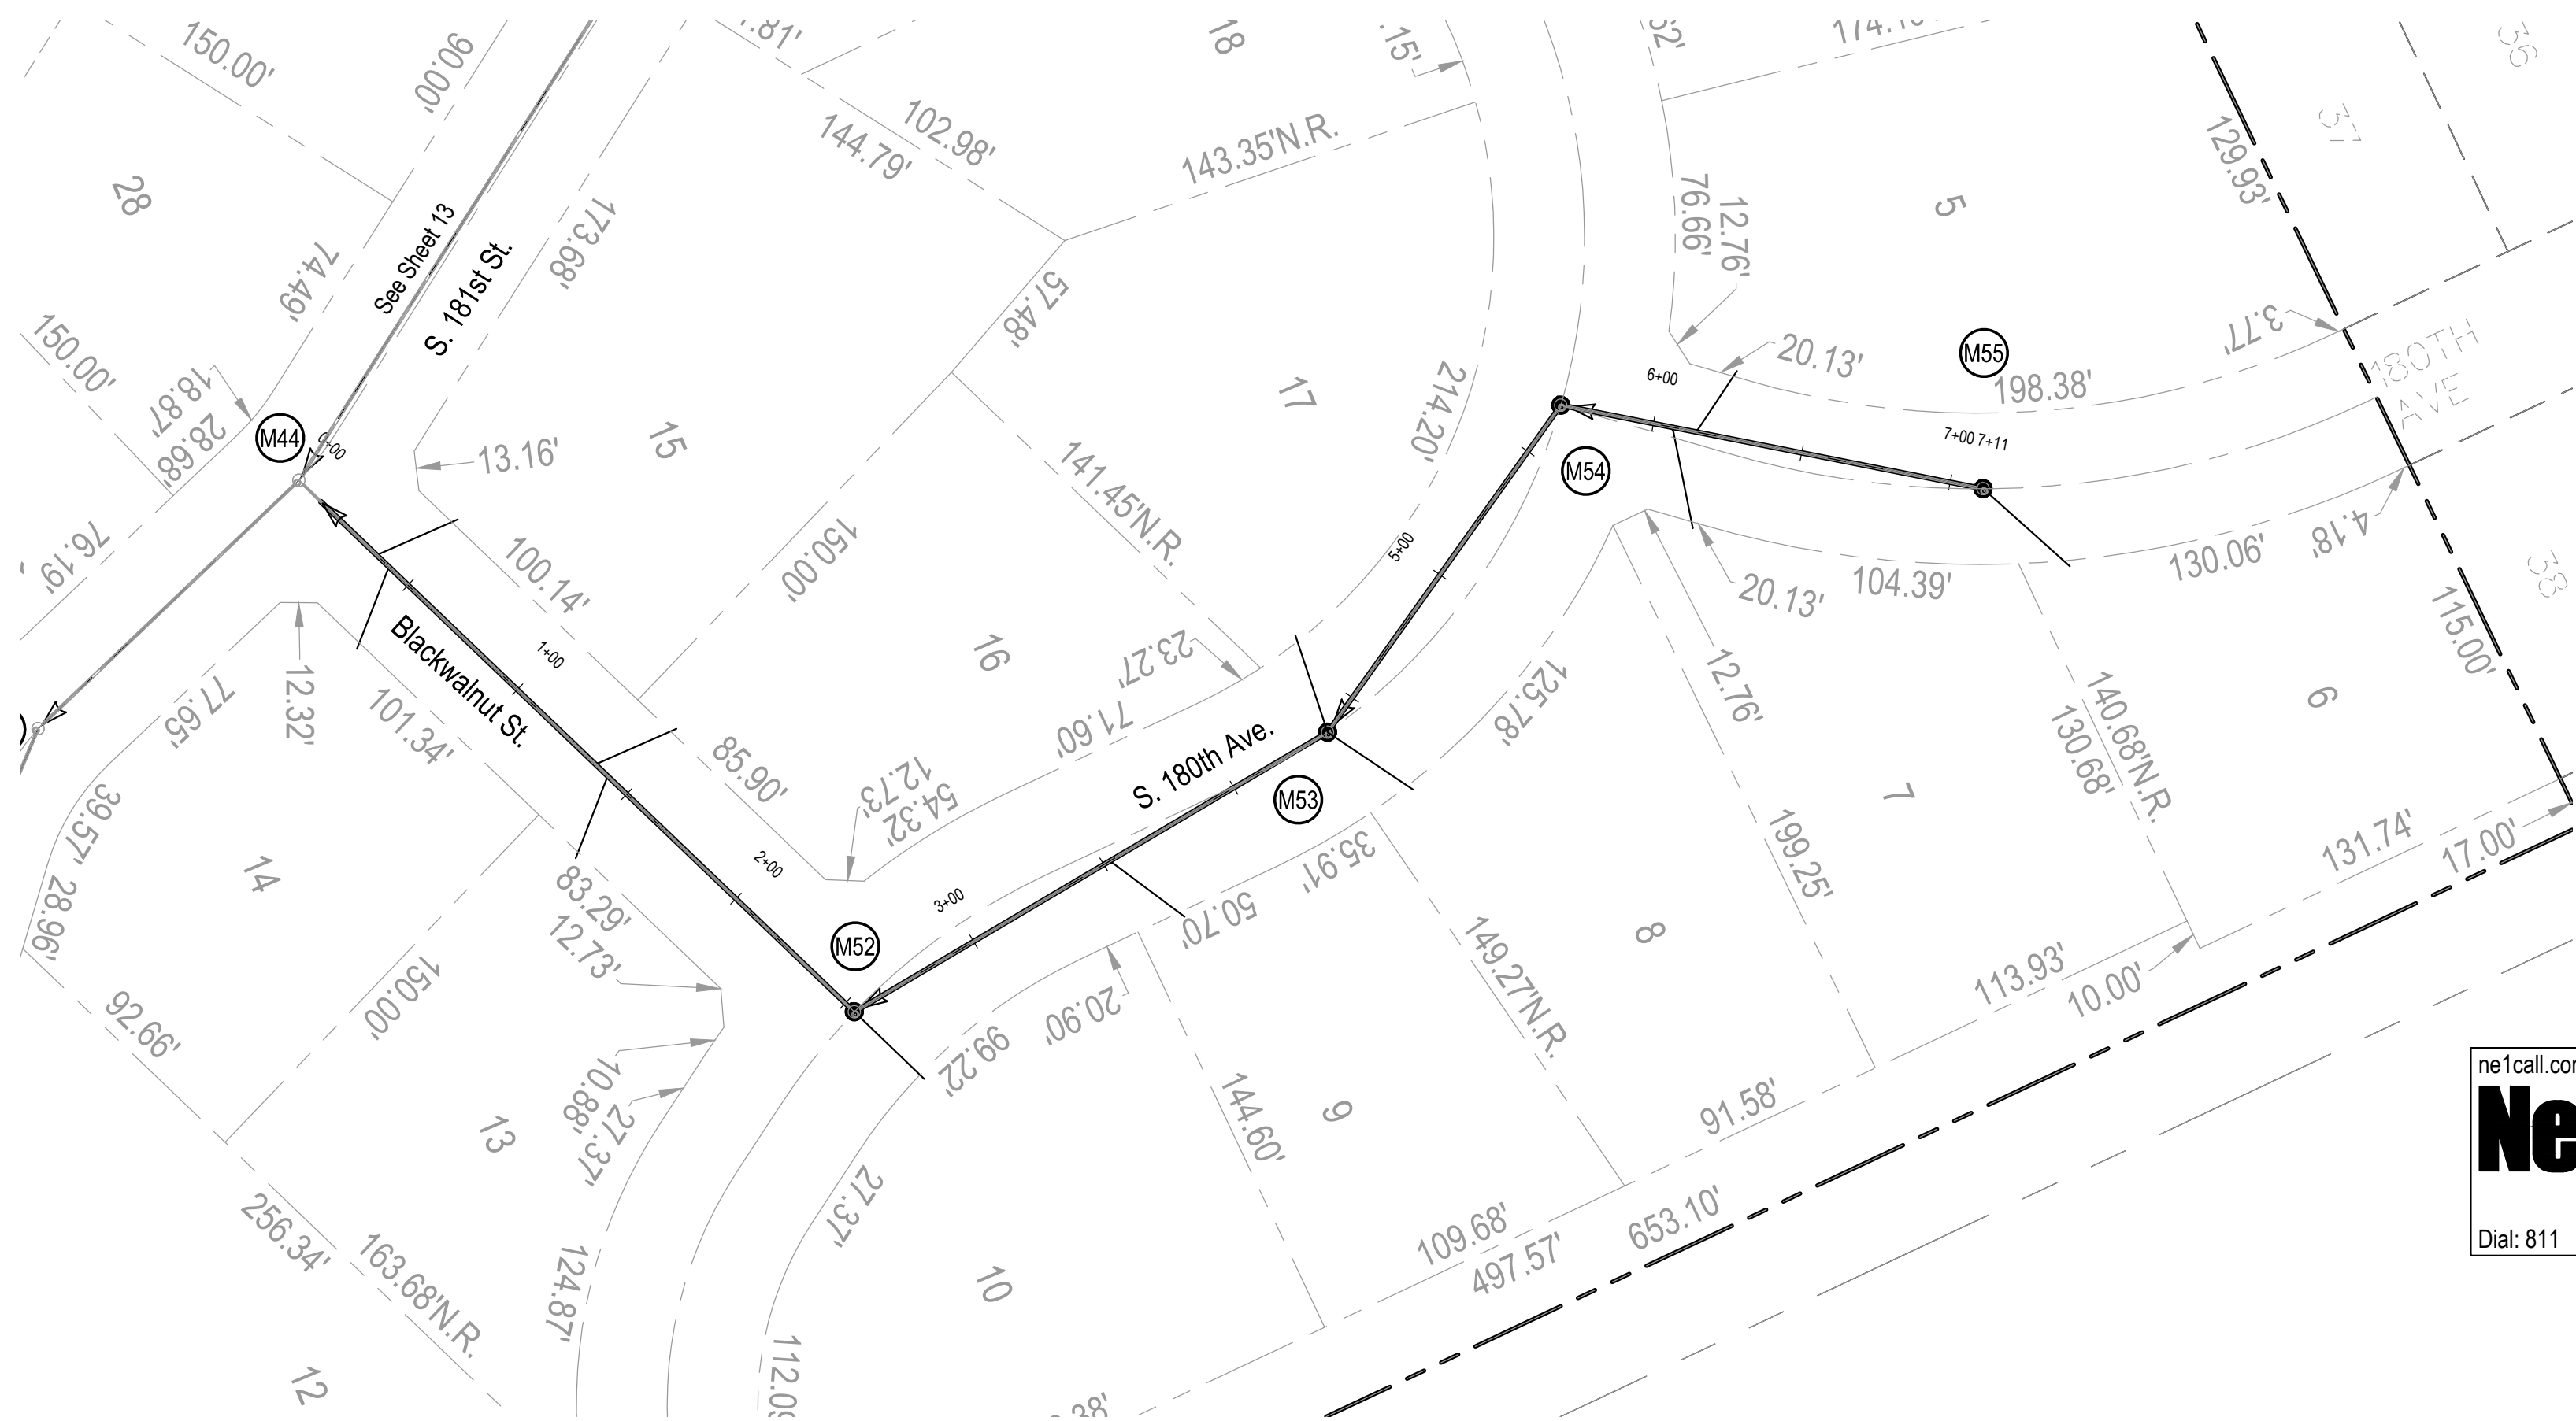

SOUTH 180TH AVENUE & BLACKWALNUT STREET

Scale: Horiz. 1"=50'
Vert. 1"=5'

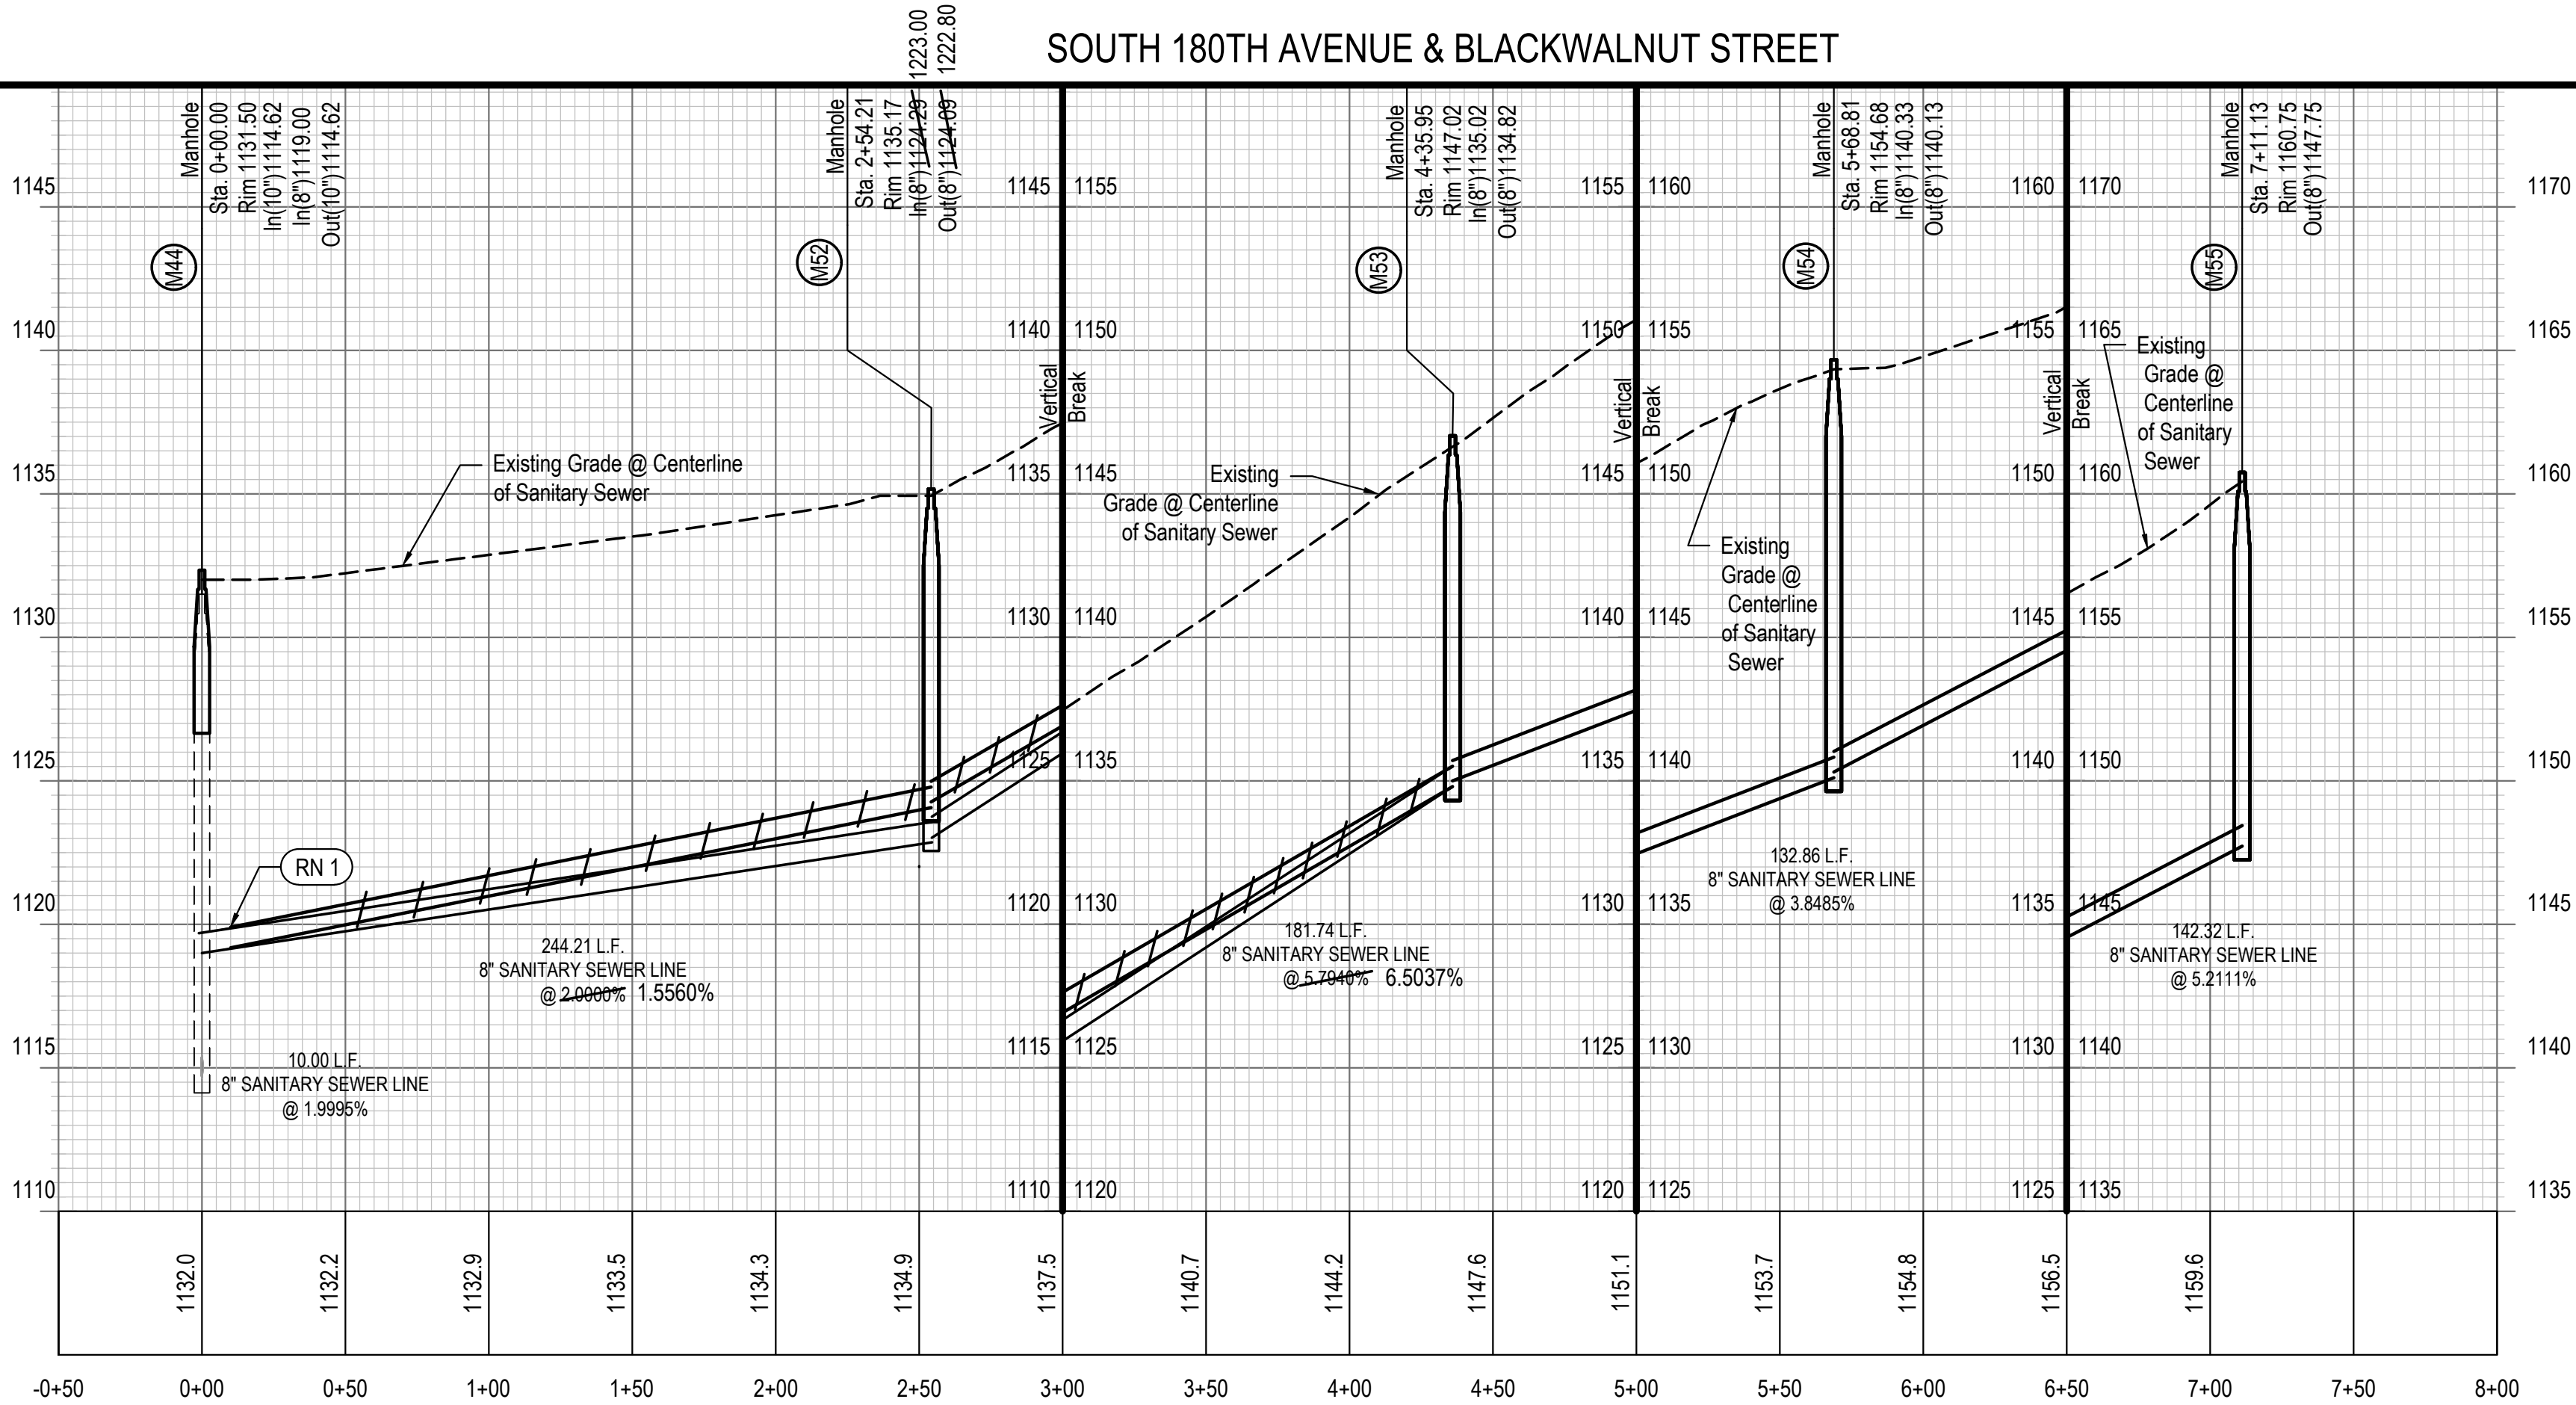

RECORD DRAWINGS

THESE PLANS HAVE BEEN REVISED TO CONFORM TO CONSTRUCTION RECORDS

REVISION DATE: 6/19/2018 BY: HLB

CHECKED BY:

CONTRACTOR: Kersten Construction, Inc.



E & A CONSULTING GROUP, INC.

6 INCH SERVICE LINE LOCATIONS					
LOT NO.	DIST. FROM PL		LENGTH L.F.	DEPTH FT.	WYE STA.
	DIST.	PROP. CORNER			
2	15'	SW	35'	12'	0+50
3	15'	SW	38' 31'	12'	1+49
4	15'	SW	36'	12'	MH 51
18	15'	NW	35'	12'	2+10
19	18'	NW	35'	12'	0+56

CONSTRUCT SANITARY SEWER MANHOLE							
ID	Sanitary Sta.	Dia.	Details	Northing	Easting	V.F.	Remarks
51	2+44.94	54"	RIM = 1155.32 INV OUT = 1143.32 (8")	514560.18	2686208.50	12.0	


NO REFERENCE NOTES

RN 1 Remove Stub, Connect to Existing Manhole

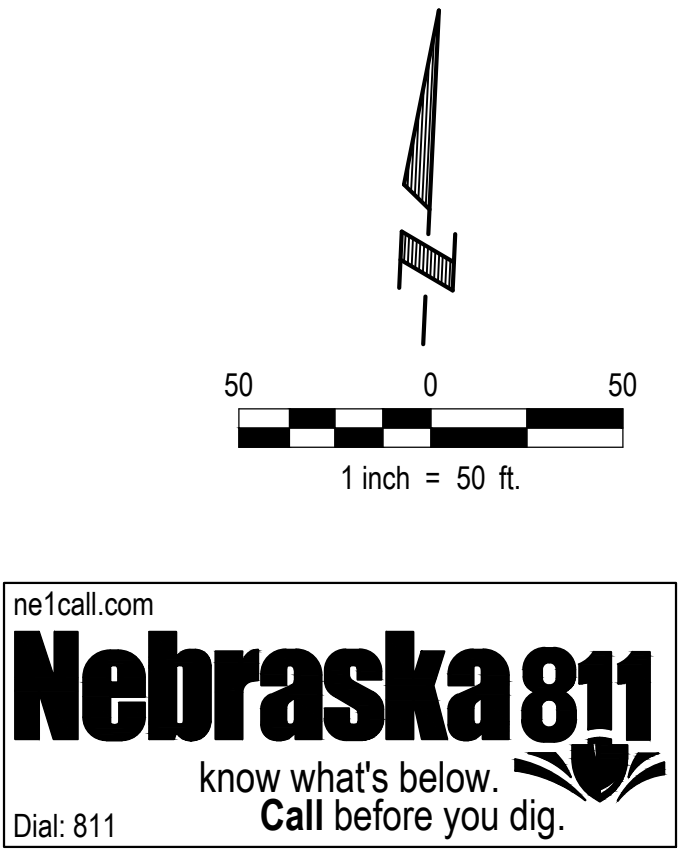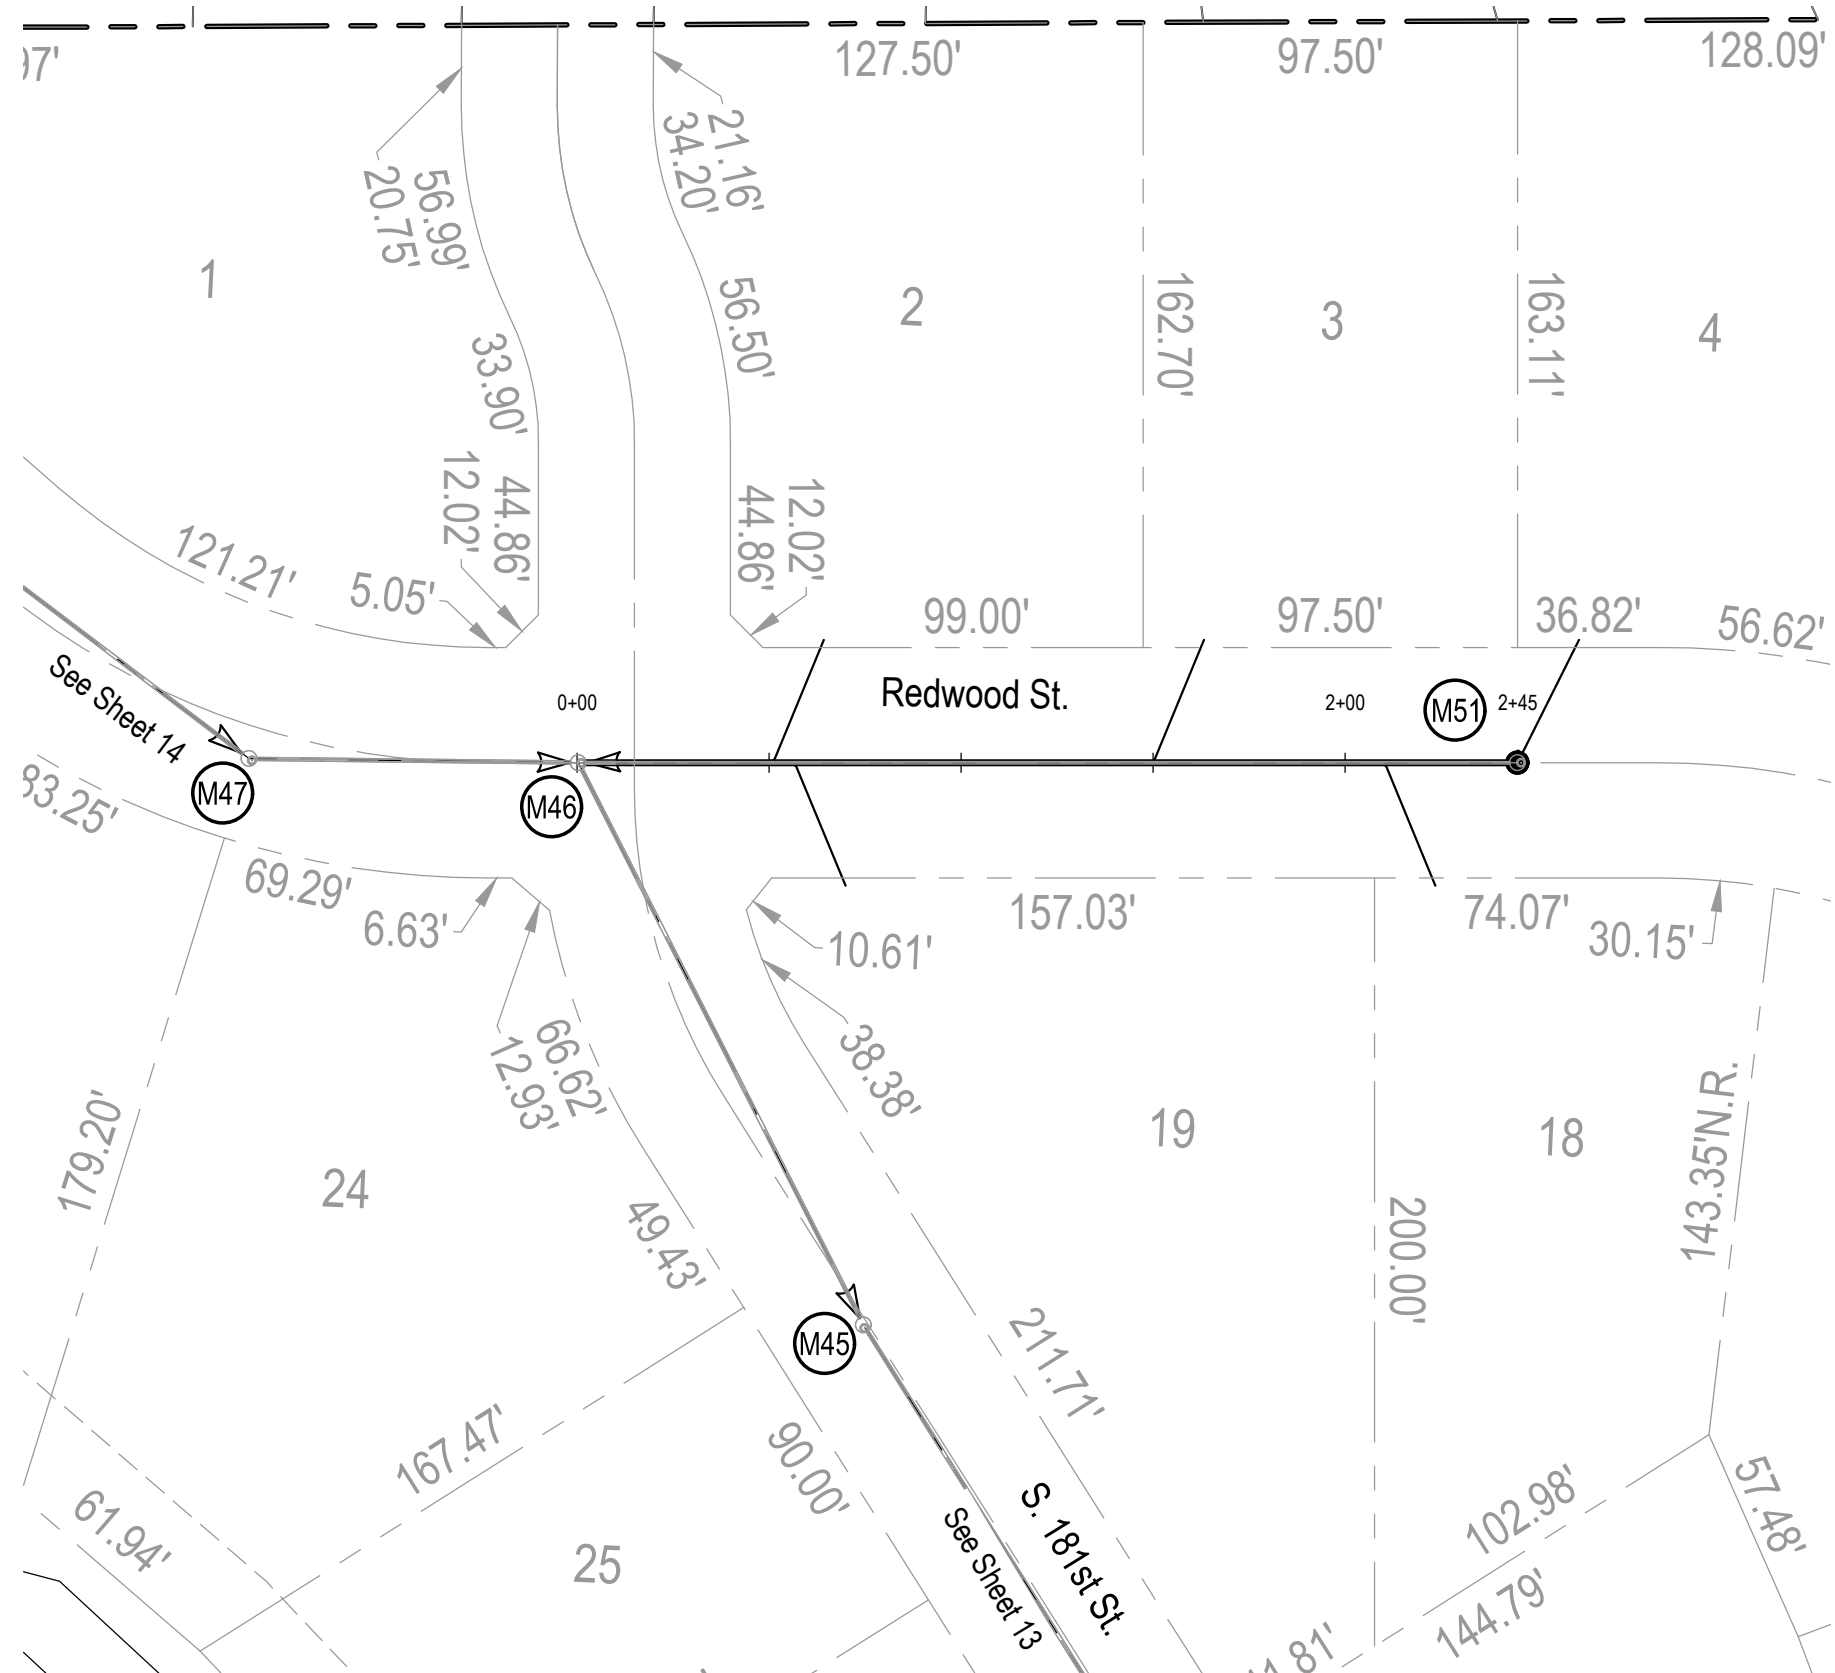

REDWOOD STREET

Scale: Horiz. 1"=50'
Vert. 1"=5'

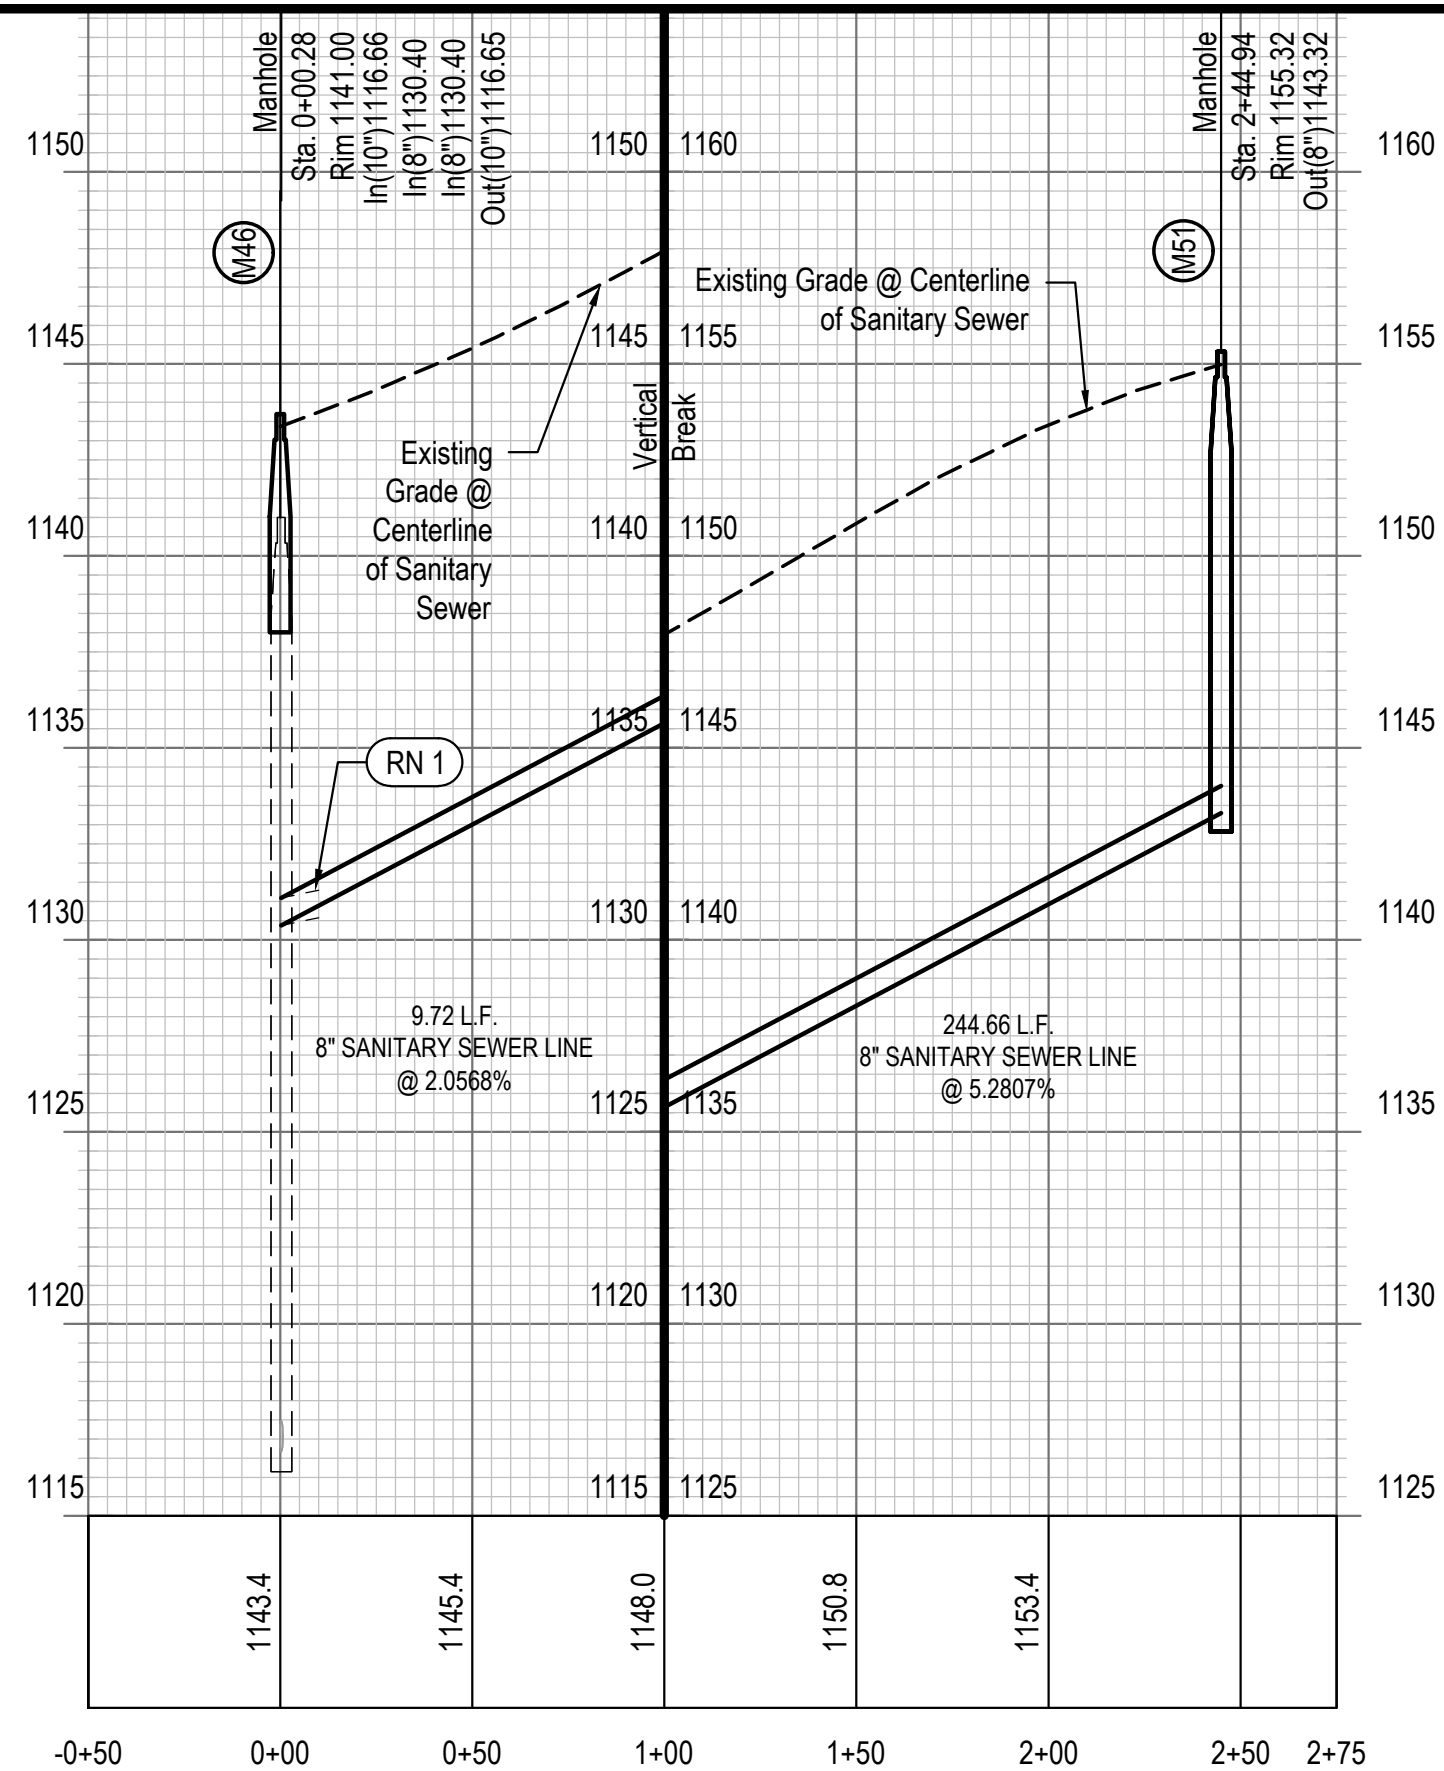

RECORD DRAWINGS

THESE PLANS HAVE BEEN REVISED TO
CONFORM TO CONSTRUCTION RECORDS

REVISION DATE: 6/19/2018 BY: HLB

CHECKED BY: RP

CONTRACTOR: Kersten Construction, Inc.

E & A CONSULTING GROUP, INC.



GARDEN OAKS
LOTS 1 THRU 147 INCLUSIVE &
OUTLOTS "A" THRU "D"
SARPY COUNTY, NEBRASKA


REDWOOD ST SANITARY
SEWER PLAN & PROFILE



Revisions		As-Built	
Date	Description	Date	Description
10/20/2016	JLW	6/19/2018	JLW
			JUN
			SEE PLAN
			Scale: 12 of 17
			Sheet: 12 of 17

E & A CONSULTING GROUP, INC.
Engineering • Planning • Environmental & Field Services

10903 Mill Valley Road, Suite 100 • Omaha, NE 68154
Phone: 402.895.4700 • Fax: 402.895.3599
www.eacg.com

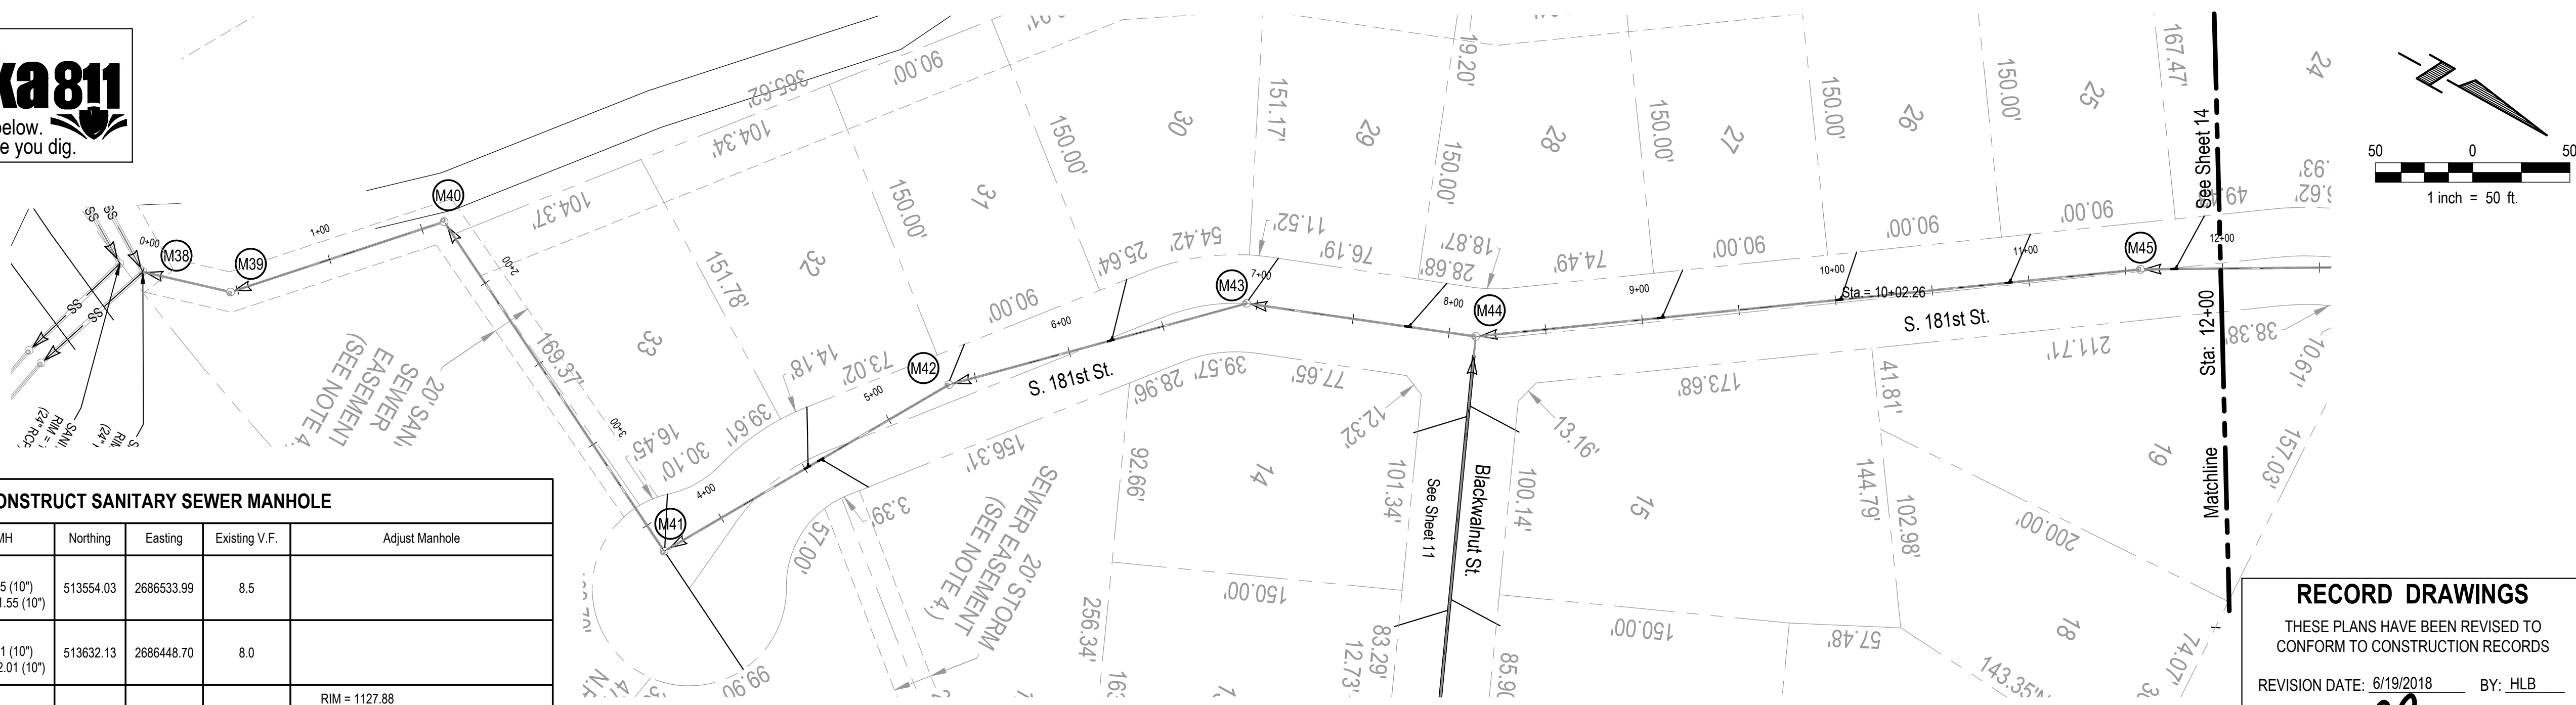


6 INCH SERVICE LINE LOCATIONS					
LOT NO.	DIST. FROM PL		LENGTH L.F.	DEPTH FT.	WYE STA.
	DIST.	PROP. CORNER			
11*	15'	SE	72'	12'	4+59.29
12*	15'	SE	27'	12'	M41
24	15'	NE	31'	12'	11+75.22
25	15'	NE	29'	11'	10+89.50
26	15'	NE	26'	12'	10+02.26
27	15'	NE	31'	12'	9+09.78

RECORD DRAWINGS	
THESE PLANS HAVE BEEN REVISED TO CONFORM TO CONSTRUCTION RECORDS	
REVISION DATE: 6/19/2018	BY: HLB
CHECKED BY: <i>RP</i>	
CONTRACTOR: Kersten Construction, Inc.	
E & A CONSULTING GROUP, INC.	

Existing Manholes will be buried by grading operation. Adjust Manhole to grade
bid item includes contractor exposing existing Manhole for adjustment

Scale: Horiz. 1"=50
Vert. 1"=5

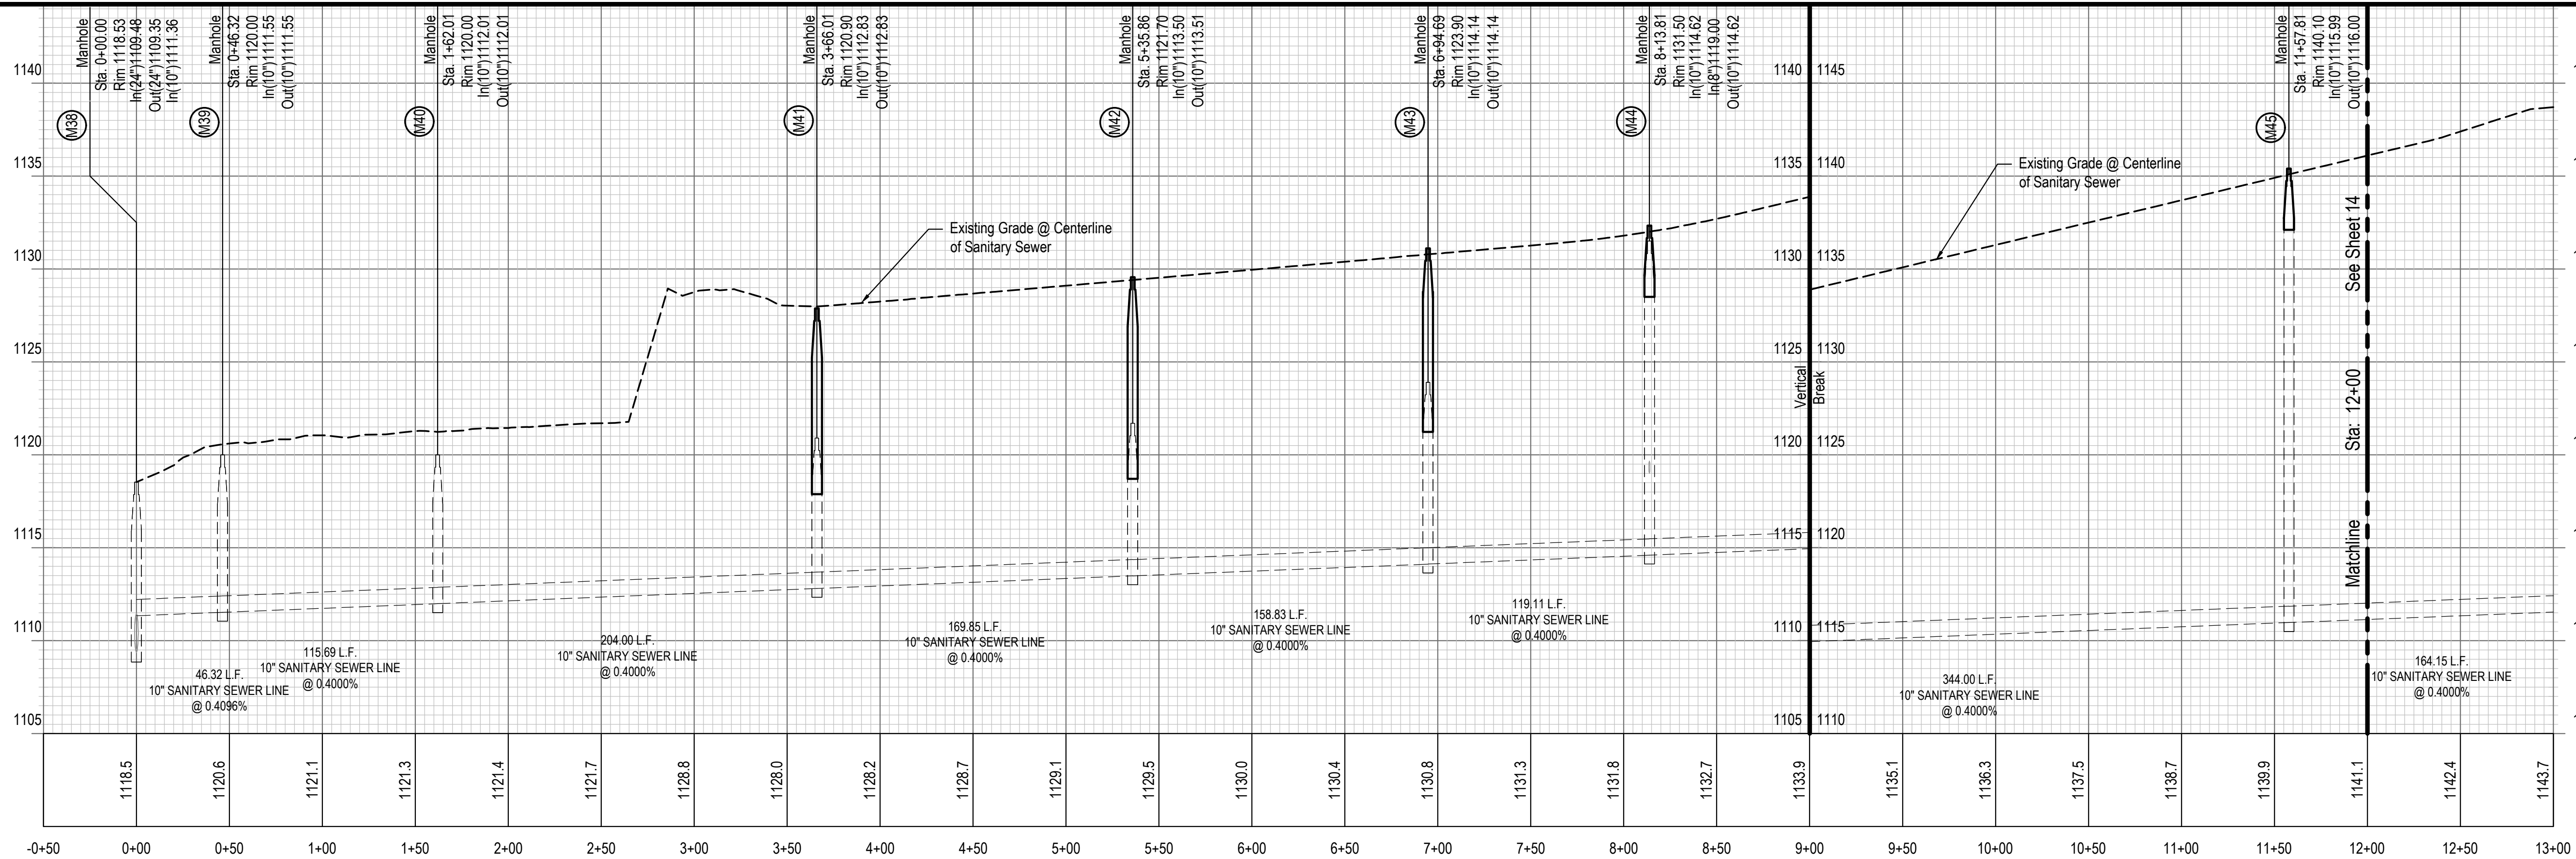

E & A CONSULTING GROUP, INC.
Engineering • Planning • Environmental & Field Services

10909 Mill Valley Road, Suite 100 • Omaha, NE 68154
Phone: 402.895.4700 • Fax: 402.895.3599
www.eacg.com



Engineering Answers

GARDEN OAKS
LOTS 1 THRU 147 INCLUSIVE &
OUTLOTS "A" THRU "D"
SARPY COUNTY, NEBRASKA

S 181st ST SANITARY
SEWER PLAN & PROFILE




Proj No:	P2015-197-001
Date:	10/20/2016
Designed By:	JLW
Drawn By:	JUN
Scale:	SEE PLAN
Sheet:	13 of 17

Holly Baty	7/11/2019 3:18 PM	K:\Projects\2015\497\01\Ss - ILAs-Bills\DWGS\SAN-000.dwg
------------	-------------------	--

CONSTRUCT SANITARY SEWER MANHOLE						
ID	Sanitary Sta.	Dia.	Existing MH	Northing	Easting	Adjust Manhole
46	13+23.05	54"	RIM = 1141.00 INV IN = 1116.66 (10") INV IN = 1130.40 (8") INV OUT = 1116.65 (10")	514548.56	2685963.93	RIM = 1143.7 Adjust Manhole 2.71 V.F.
47	14+08.77	54"	RIM = 1135.50 INV IN = 1116.99 (10") INV OUT = 1117.00 (10")	514544.62	2685878.33	RIM = 1141.15 Adjust Manhole 5.65 V.F.
48	16+52.53	54"	RIM = 1132.10 INV IN = 1117.98 (10") INV OUT = 1117.97 (10")	514678.09	2685674.46	RIM = 1135.51 Adjust Manhole 3.41 V.F.
49	19+66.25	54"	RIM = 1128.50 INV IN = 1119.23 (10") INV OUT = 1119.23 (10")	514695.96	2685361.37	RIM = 1128.97 Adjust Manhole 0.47 V.F.



Existing Manholes will be buried by grading operation. Adjust Manhole to grade
bid item includes contractor exposing existing Manhole for adjustment

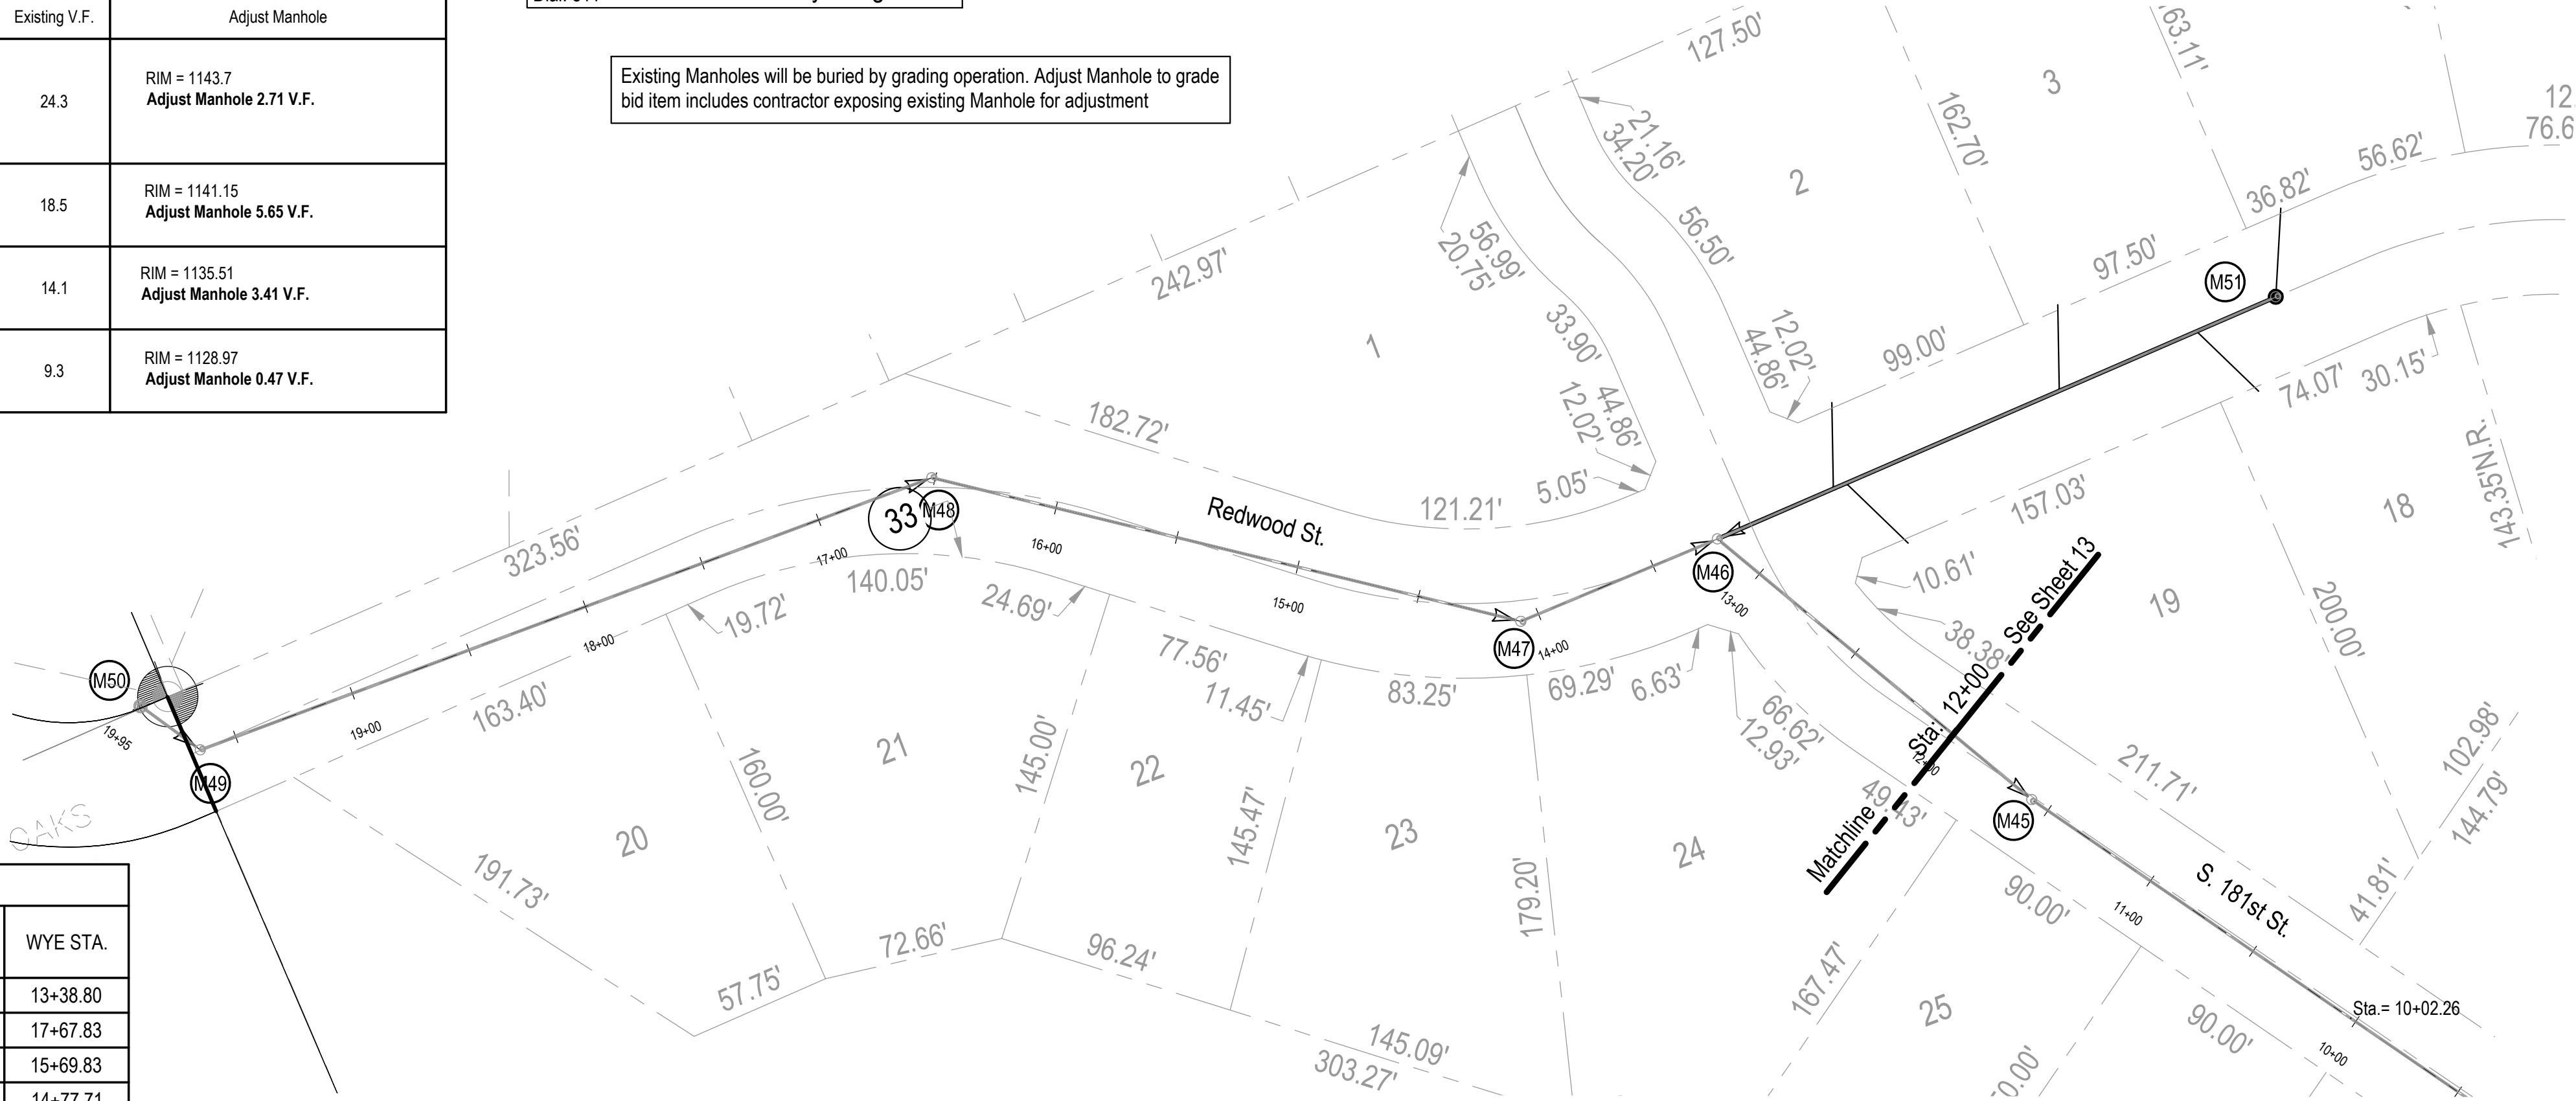


* Service line locations were constructed from the Sanitary Improvement District No. 235 Sanitary Siphon Replacement (Sunridge) plan by Lamp Rynearson & Associates. All locations and depths are estimates.

6 INCH SERVICE LINE LOCATIONS					
LOT NO.	DIST. FROM PL		LENGTH L.F.	DEPTH FT.	WYE STA.
	DIST.	PROP. CORNER			
1*	15'	SE	33'	12'	13+38.80
20*	15'	NE	33'	12'	17+67.83
21*	15'	NE	31'	12'	15+69.83
22*	15'	NE	38'	12'	14+77.71
23*	15'	NE	24'	12'	M47

REDWOOD STREET & SOUTH 181ST STREET

Scale: Horiz. 1"=50'
Vert. 1"=5'

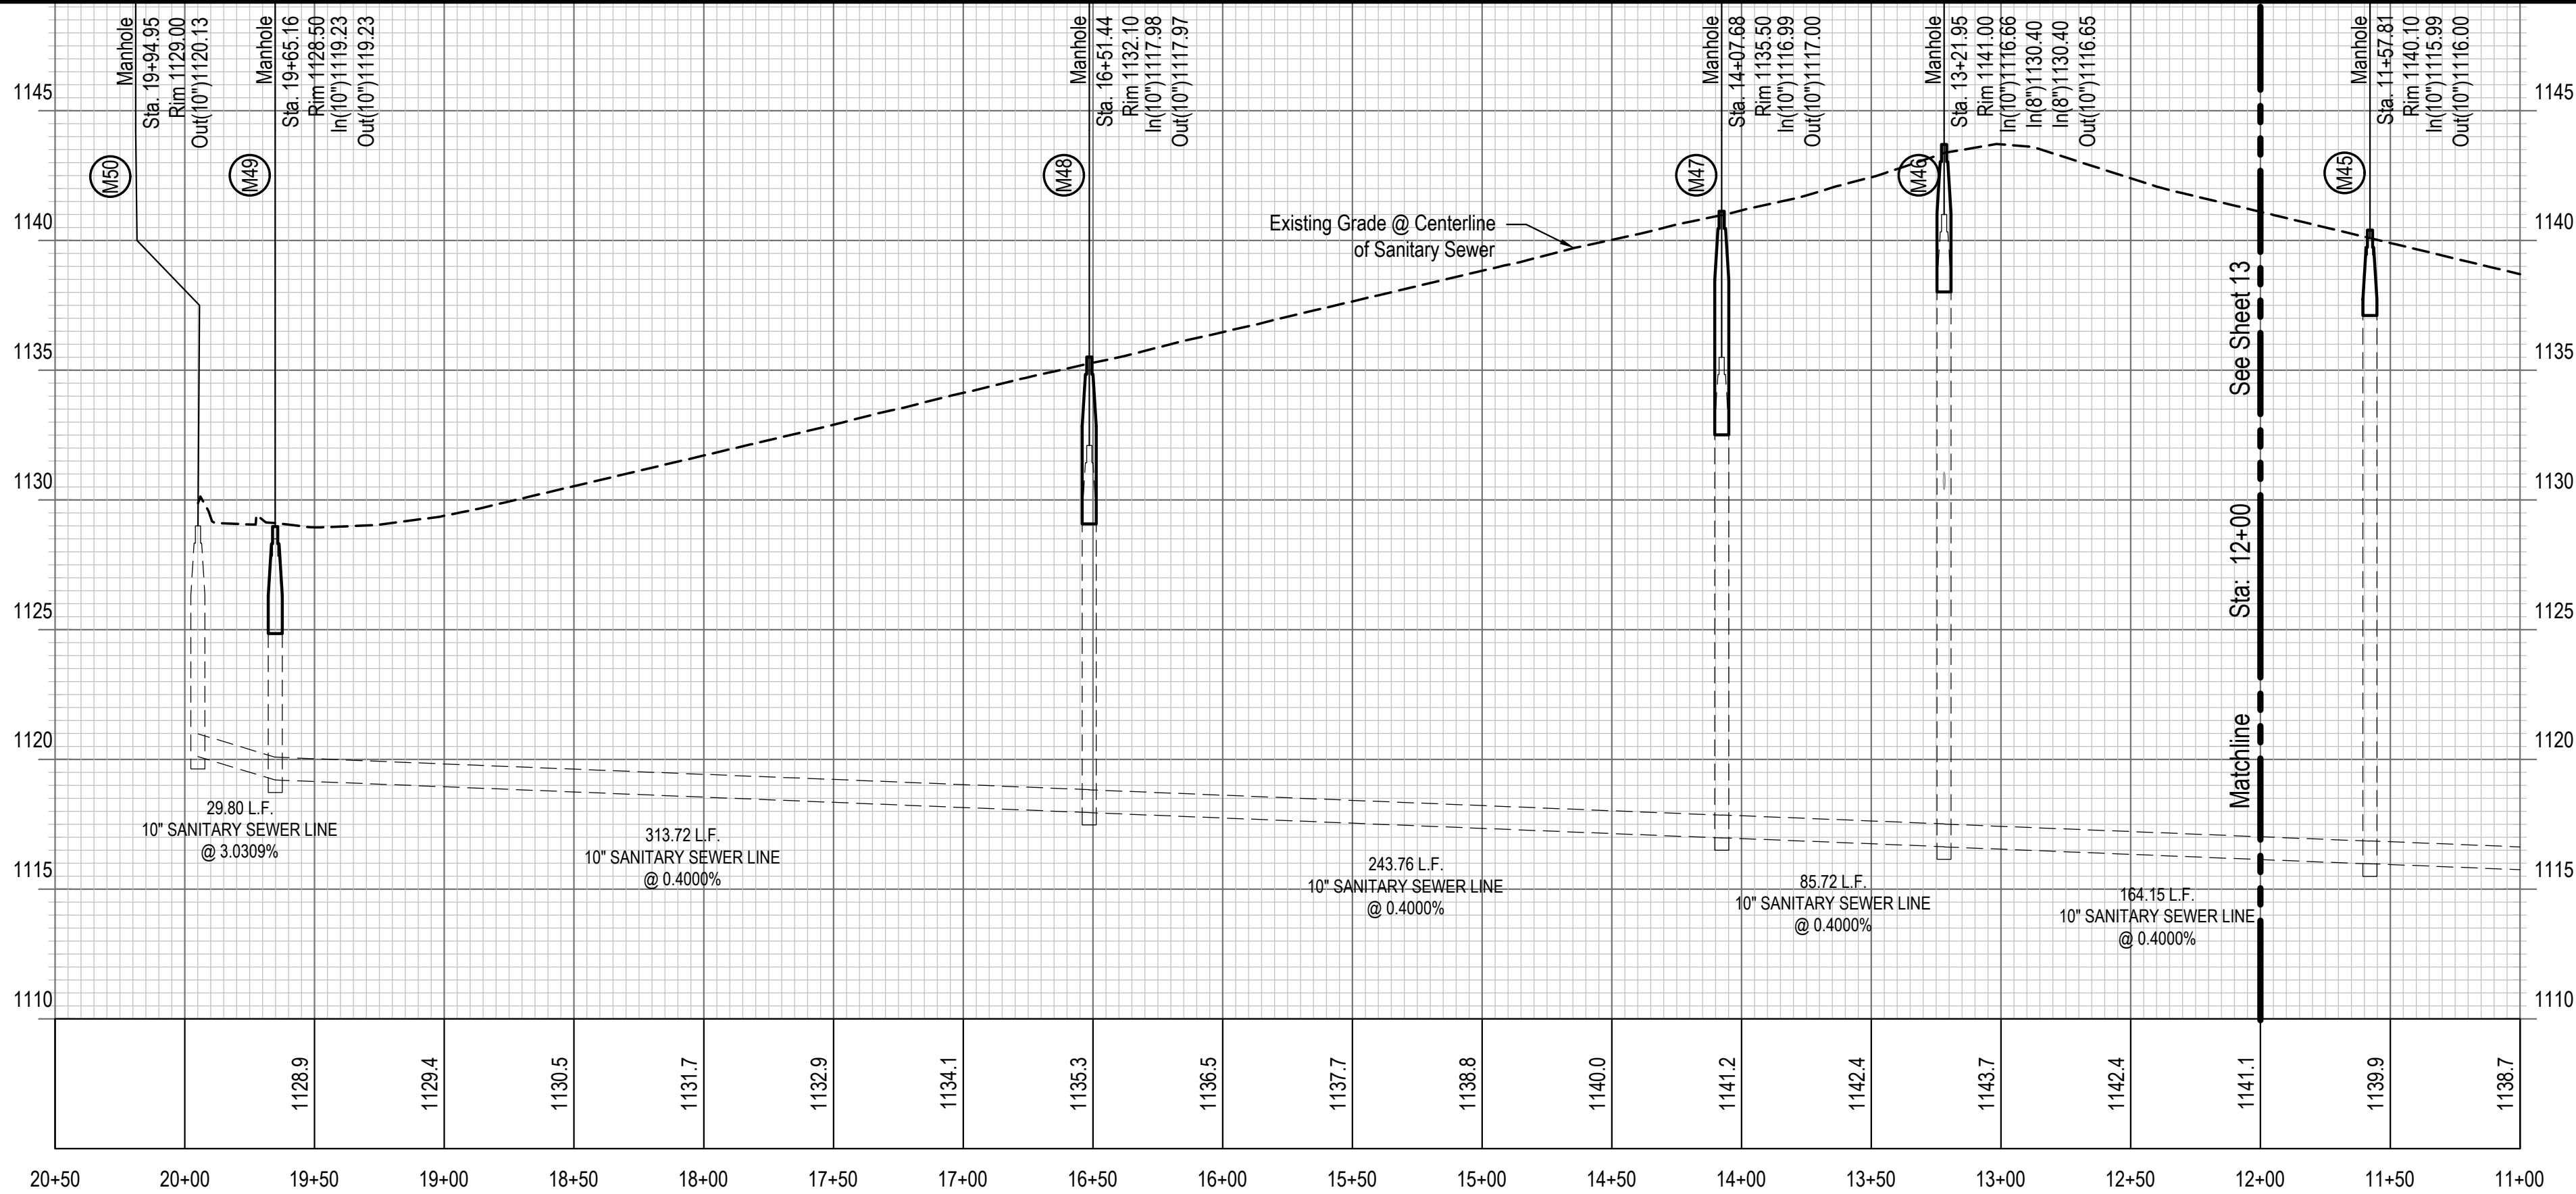

RECORD DRAWINGS
THESE PLANS HAVE BEEN REVISED TO
CONFORM TO CONSTRUCTION RECORDS

REVISION DATE: 6/19/2018 BY: HLB

CHECKED BY: *RP*

CONTRACTOR: Kersten Construction, Inc.

E & A CONSULTING GROUP, INC.

E & A CONSULTING GROUP, INC.
Engineering • Planning • Environmental & Field Services

10903 Mill Valley Road, Suite 100 • Omaha, NE 68154
Phone: 402.895.4700 • Fax: 402.895.3599
www.eagroup.com

E & A CONSULTING GROUP, INC.
Engineering Answers


GARDEN OAKS
LOTS 1 THRU 147 INCLUSIVE &
OUTLOTS "A" THRU "D"
SARPY COUNTY, NEBRASKA

REDWOOD ST & S 181st
ST SANITARY SEWER
PLAN & PROFILE

Revisions
Date
Description
As-Built
0
10/20/2016
JLW
JLN
SEE PLAN
14 of 17
6/21/2018 2:38 PM K:\Projects\2015\487\001\SS - 181st-Building\WGSAH-000.dwg Holly Bay



6 INCH SERVICE LINE LOCATIONS					
LOT NO.	DIST. FROM PL		LENGTH L.F.	DEPTH FT.	WYE STA.
	DIST.	PROP. CORNER			
98*	72'	SW	29'	11'	6+67
99*	73'	NW	29'	11'	6+62
111*	61'	SE	27'	11'	7+85
112*	46'	NE	35'	11'	8+13
127*	50'	SE	12'	11'	10+09
128*	45'	NE	25'	11'	9+99

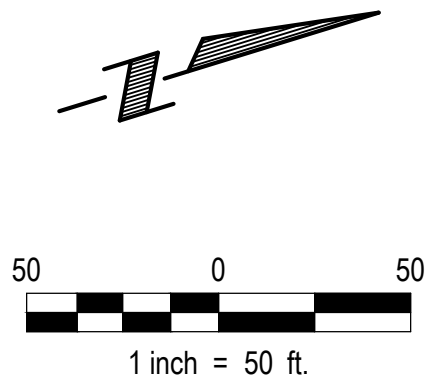


* River Oaks Lots

CONSTRUCT SANITARY SEWER MANHOLE						
ID	Sanitary Sta.	Dia.	Details	Northing	Easting	V.F.
57	1+40.31	54"	RIM = 1132.08 INV IN = 1118.55 (8") INV OUT = 1118.35 (8")	514329.36	2685365.65	13.7
58	4+73.23	54"	RIM = 1131.08 INV IN = 1120.08 (8") INV OUT = 1119.88 (8")	513996.89	2685380.23	11.2
59	6+38.46	54"	RIM = 1133.36 INV IN = 1120.94 (8") INV IN = 1120.94 (8") INV OUT = 1120.74 (8")	513831.88	2685387.39	12.6
60	7+85.15	54"	RIM = 1135.86 INV IN = 1124.66 (8") INV OUT = 1124.56 (8")	513825.49	2685240.89	11.3
60A	8+12.89	54"	RIM = 1135.82 INV IN = 1124.91 (8") INV OUT = 1124.81 (8")	513852.97	2685237.20	11.0

- NO REFERENCE NOTES
- RN 1 Tap Existing Manhole, Existing Sarpy County Interceptor Sewer, Contractor to Verify Invert Elevation
- RN 2 20' Wide Sanitary Sewer Easement Granted to SID 313, SID 309, and Sarpy County
- RN 3 50' Wide Sanitary Sewer Easement Granted to SID 313, SID 309, and Sarpy County
- RN 4 Provide 8" Sanitary Sewer with Capped end, 10 LF @ 2.92%
- RN 5 Provide 8" Sanitary Sewer with Capped end, 10 LF @ 4.98%
- RN 6 Coordinate Connection to Interceptor Sewer with City of Gretna. City Representative Shall be Notified of Connection Schedule and be Present at the Time of Connection.
- RN 7 30' Wide Sanitary Sewer Easement Granted to SID 313, SID 309, and Sarpy County

Scale: Horiz. 1"=50'
Vert. 1"=5'

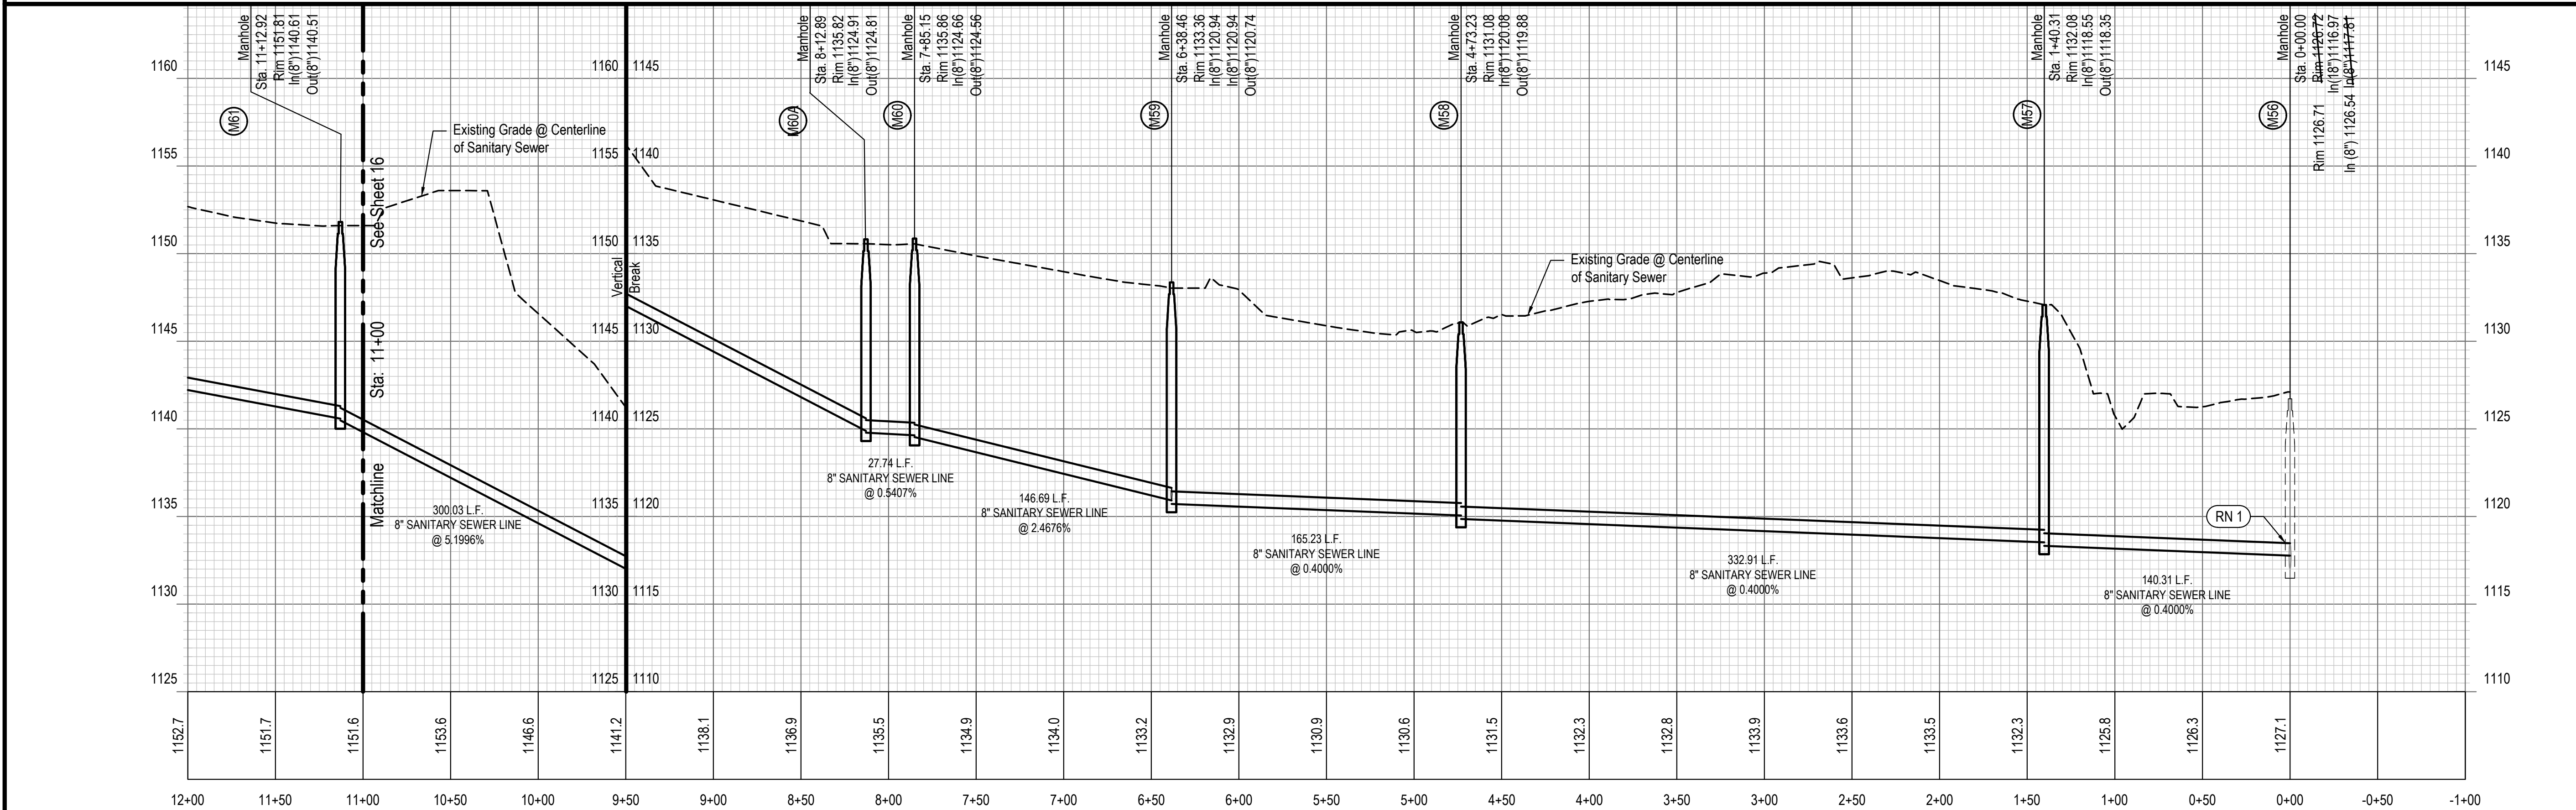

ne1call.com
Nebraska 811
know what's below.
Call before you dig.

E & A CONSULTING GROUP, INC.
Engineering • Planning • Environmental & Field Services
10903 Mill Valley Road, Suite 100 • Omaha, NE 68154
Phone: 402.895.4700 • Fax: 402.895.3599
www.eacg.com

E & A CONSULTING GROUP, INC.
Engineering Answers

GARDEN OAKS
LOTS 1 THRU 147 INCLUSIVE &
OUTLOTS "A" THRU "D"
SARPY COUNTY, NEBRASKA

**S 184TH TERRACE
(RIVER OAKS) SANITARY
SEWER PLAN & PROFILE**

Revisions		Date		Description	
1	0	6/19/2016	JLW	As-Built	

Proj No:	P2015-497-001	Drawn By:	JUN
Date:	10/20/2016	Scale:	SEE PLAN
		Sheet:	15 of 17

6/21/2016 2:46 PM K:\Projects\2015\497\001\SS - 184th-Building\WG SAN-000.dwg
Heli Bay

6 INCH SERVICE LINE LOCATIONS					
LOT NO.	DIST. FROM PL		LENGTH L.F.	DEPTH FT.	WYE STA.
	DIST.	PROP. CORNER			
71	15'	NW	32'	11'	20+33
72	15'	NW	40'	11'	19+57
73	15'	NW	37'	11'	18+75
74	15'	NE	22'	11'	18+82
75	15'	NE	19'	11'	19+69
76	15'	NE	36'	11'	20+53
129*	10'	NW	33'	11'	11+88
130*	10'	NW	32'	11'	12+48
131*	10'	NW	31'	11'	13+14
136*	9'	NE	28'	11'	13+08
137*	8'	NE	27'	11'	12+43
138*	10'	NE	26'	11'	11+94
139*	23'	NE	27'	11'	11+35
140*	11'	SE	27'	11'	11+13
157*	49'	SE	29'	11'	15+98
158*	45'	NE	29'	11'	15+93
159*	10'	NW	34'	11'	18+06
160*	10'	NE	24'	11'	18+26
161*	13'	NE	27'	11'	17+63
162*	28'	NE	31'	11'	17+10 MH63

* River Oaks Lots

NO REFERENCE NOTES



RN 1 50' Wide Sanitary Sewer Easement Granted to SID 313, SID 309, and Sarpy County

RN 2 Provide 8" Sanitary Sewer with Capped end, 10 LF @ 1.08%

RN 3 Provide 8" Sanitary Sewer with Capped end, 10 LF @ 2.10%

CONSTRUCT SANITARY SEWER MANHOLE						
ID	Sanitary Sta.	Dia.	Details	Northing	Easting	V.F.
61	11+12.92	54"	RIM = 1151.81 INV IN = 1140.61 (8") INV OUT = 1140.51 (8")	513812.57	2684940.02	11.3
62	0+00.00	54"	RIM = 1157.46 INV IN = 1146.26 (8") INV IN = 1146.26 (8") INV OUT = 1146.16 (8")	513516.40	2684957.05	11.3
63	17+09.69	54"	RIM = 1163.53 INV IN = 1152.33 (8") INV OUT = 1152.23 (8")	513504.16	2684657.41	11.3
64	20+52.87	54"	RIM = 1175.49 INV OUT = 1163.49 (8")	513161.10	2684658.70	12.0

SOUTH 184TH TERRACE (RIVER OAKS)

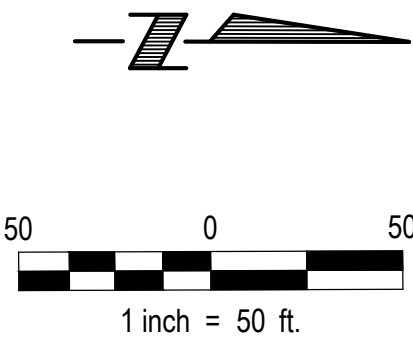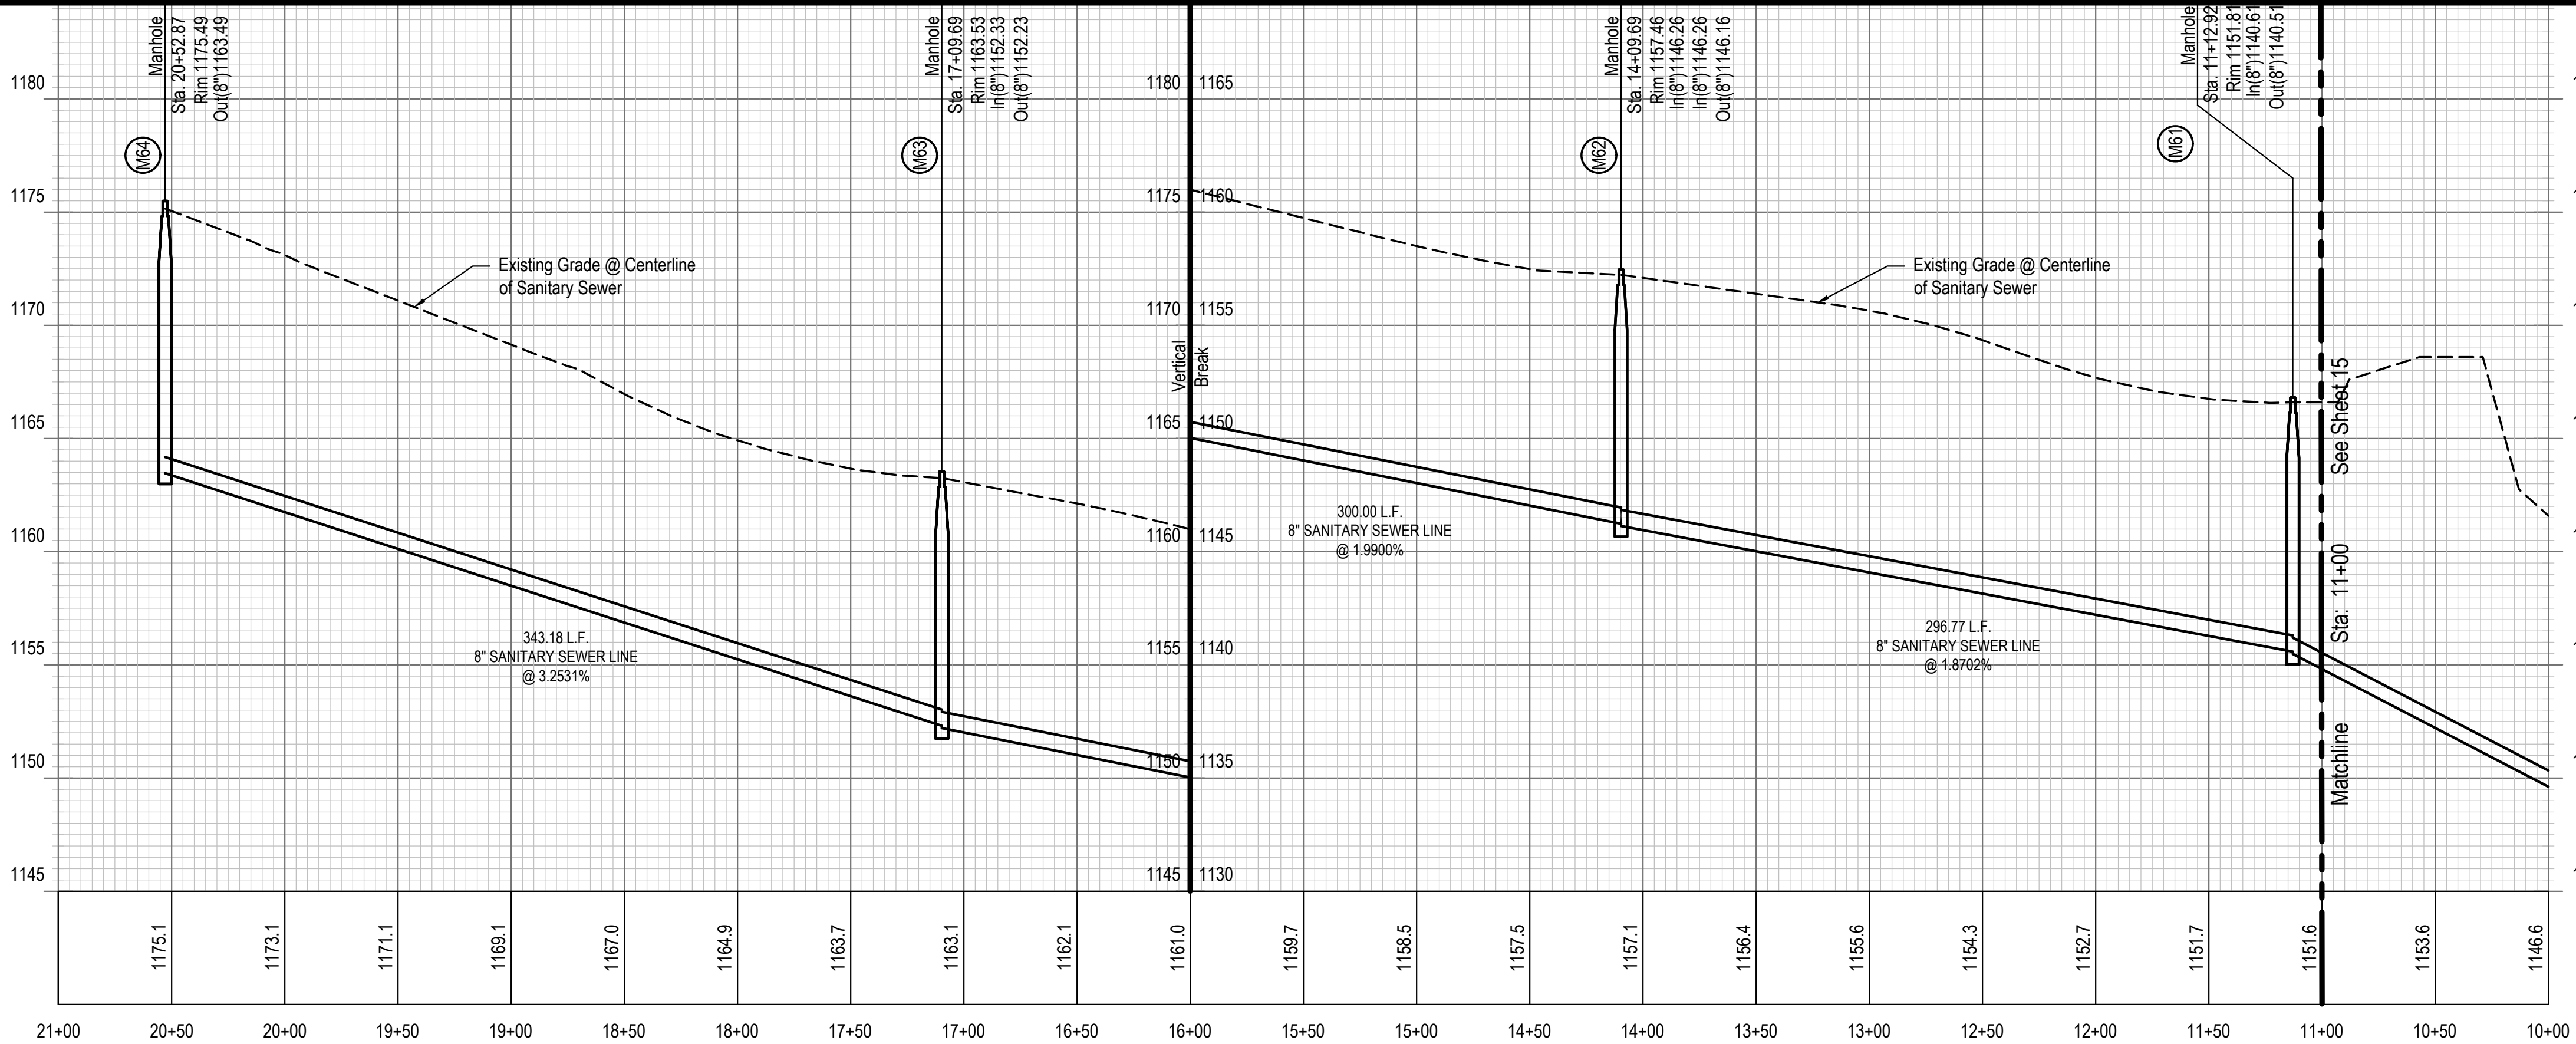

ne1call.com
Nebraska 811
know what's below.
Call before you dig.
Dial: 811

RECORD DRAWINGS
THESE PLANS HAVE BEEN REVISED TO
CONFORM TO CONSTRUCTION RECORDS
REVISION DATE: 6/19/2018 BY: HLB
CHECKED BY: *RL*
CONTRACTOR: Kersten Construction, Inc.
E & A CONSULTING GROUP, INC.

Scale: Horiz. 1"=50'
Vert. 1"=5'

E & A CONSULTING GROUP, INC.
Engineering • Planning • Environmental & Field Services



Engineering Answers

GARDEN OAKS
LOTS 1 THRU 147 INCLUSIVE &
OUTLOTS "A" THRU "D"
SARPY COUNTY, NEBRASKA


S 184TH TERRACE
(RIVER OAKS) SANITARY
SEWER PLAN & PROFILE



Revisions		Revisions	
Date	Description	Date	Description
10/20/2016	As-Built	0	
10/20/2016	JLW	10/20/2016	JLW
	SEE PLAN		SEE PLAN
	16 of 17		16 of 17

6 INCH SERVICE LINE LOCATIONS					
LOT NO.	DIST. FROM PL		LENGTH L.F.	DEPTH FT.	WYE STA.
	DIST.	PROP. CORNER			
34	15'	SW	30'	11'	0+14
35	15'	SW	27'	12'	MH 66
36	15'	SW	38'	12'	1+41
37	15'	NW	38'	11'	MH 67
38	15'	NW	37'	12'	2+57
39	15'	NW	29'	12'	3+29
40	15'	NW	31'	11.5'	MH 69
48	20'	NW	29'	12'	0+19
49	15'	NE	31'	12'	MH 68
50	15'	NE	29'	12'	3+79

CONSTRUCT SANITARY SEWER MANHOLE							
ID	Sanitary Sta.	Dia.	Details	Northing	Easting	V.F.	Remarks
66	0+94.22	54"	RIM = 1134.28 INV IN = 1122.90 (8") INV OUT = 1122.70 (8")	513834.23	2685481.55	11.8 12.5	RIM= 1135.33 INV OUT= 1122.84 (8")
67	1+87.01	54"	RIM = 1136.73 INV IN = 1125.25 (8") INV OUT = 1125.05 (8")	513790.59	2685563.40	11.7	INV OUT= 1125.06 (8")
68	2+95.89	54"	RIM = 1139.82 INV IN = 1128.06 (8") INV OUT = 1127.86 (8")	513686.50	2685595.23	11.8 12.0	RIM= 1139.89 INV OUT= 1127.90 (8")
69	4+05.99	54"	RIM = 1142.20 INV OUT = 1130.37 (8")	513576.53	2685599.53	11.8 11.7	INV OUT= 1130.48 (8")


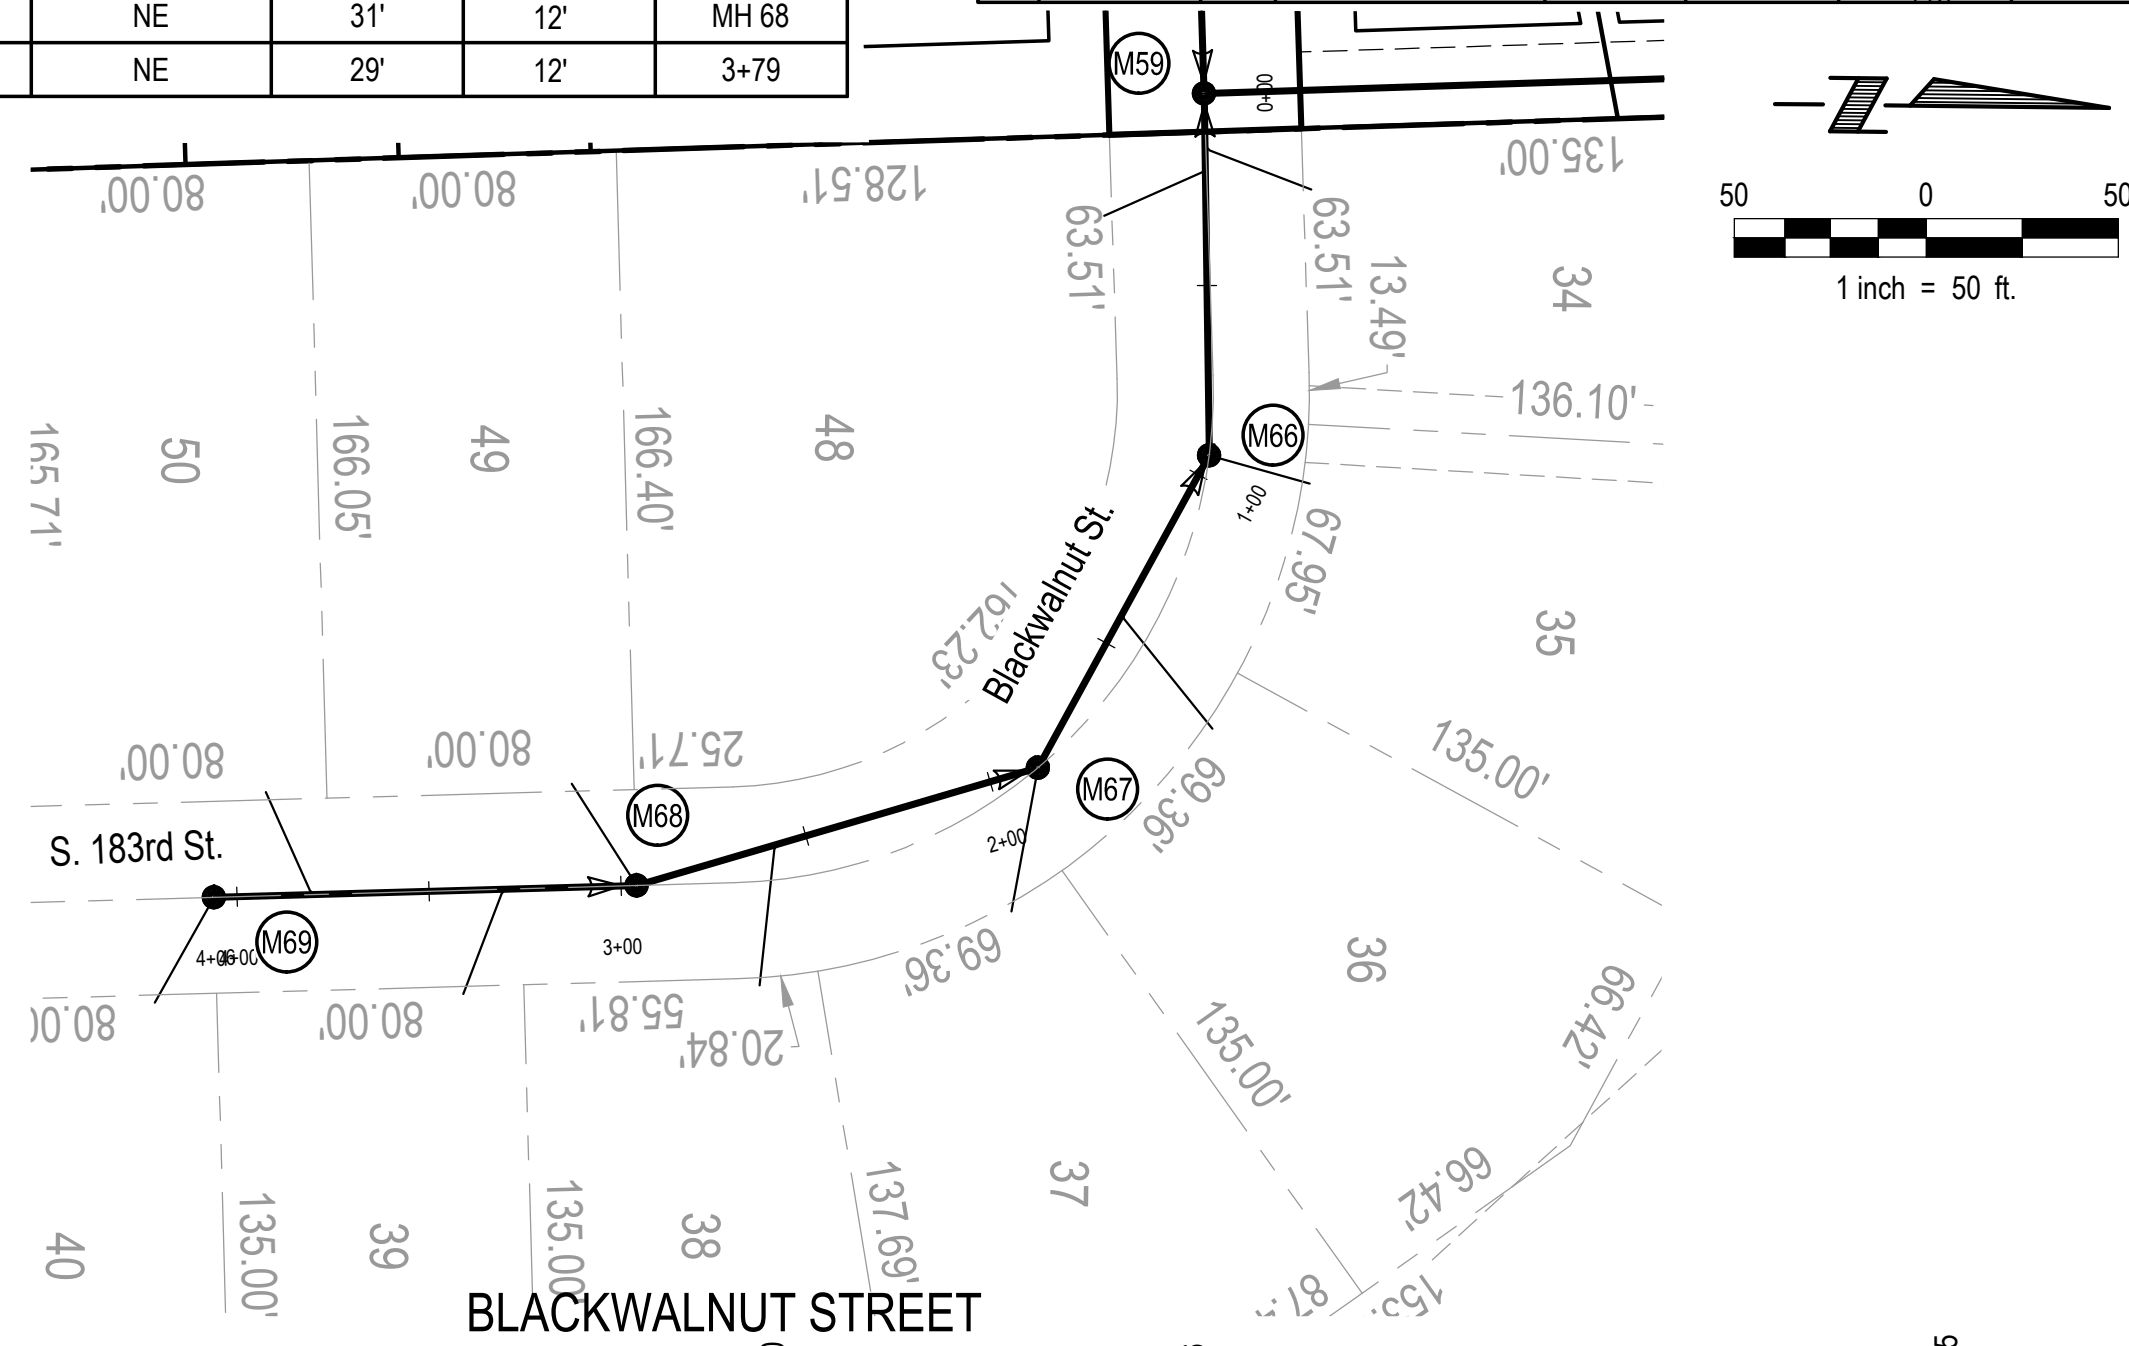


6 INCH SERVICE LINE LOCATIONS					
LOT NO.	DIST. FROM PL		LENGTH L.F.	DEPTH FT.	WYE STA.
	DIST.	PROP. CORNER			
62	15'	NW	21'	12'	2+52
63	15'	NW	22'	12'	1+73
64	15'	NE	37'	11'	1+65
65	15'	NE	38'	12'	2+45
66	15'	NE	30'	12'	3+17

6 INCH SERVICE LINE LOCATIONS					
LOT NO.	DIST. FROM PL		LENGTH L.F.	DEPTH FT.	WYE STA.
	DIST.	PROP. CORNER			
132*	60'	SW	28'	11'	0+31
133*	10'	NW	25'	11'	1+02
134*	10'	NE	34'	11'	0+96
135*	62'	SE	31'	11'	0+25

* River Oaks Lots

CONSTRUCT SANITARY SEWER MANHOLE							
ID	Sanitary Sta.	Dia.	Details	Northing	Easting	V.F.	Remarks
65	3+17.50	54"	RIM = 1166.92 INV OUT = 1154.92 (8")	513200.07	2684982.83	12.0	

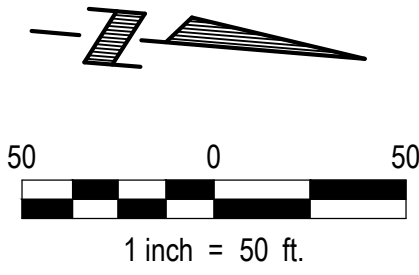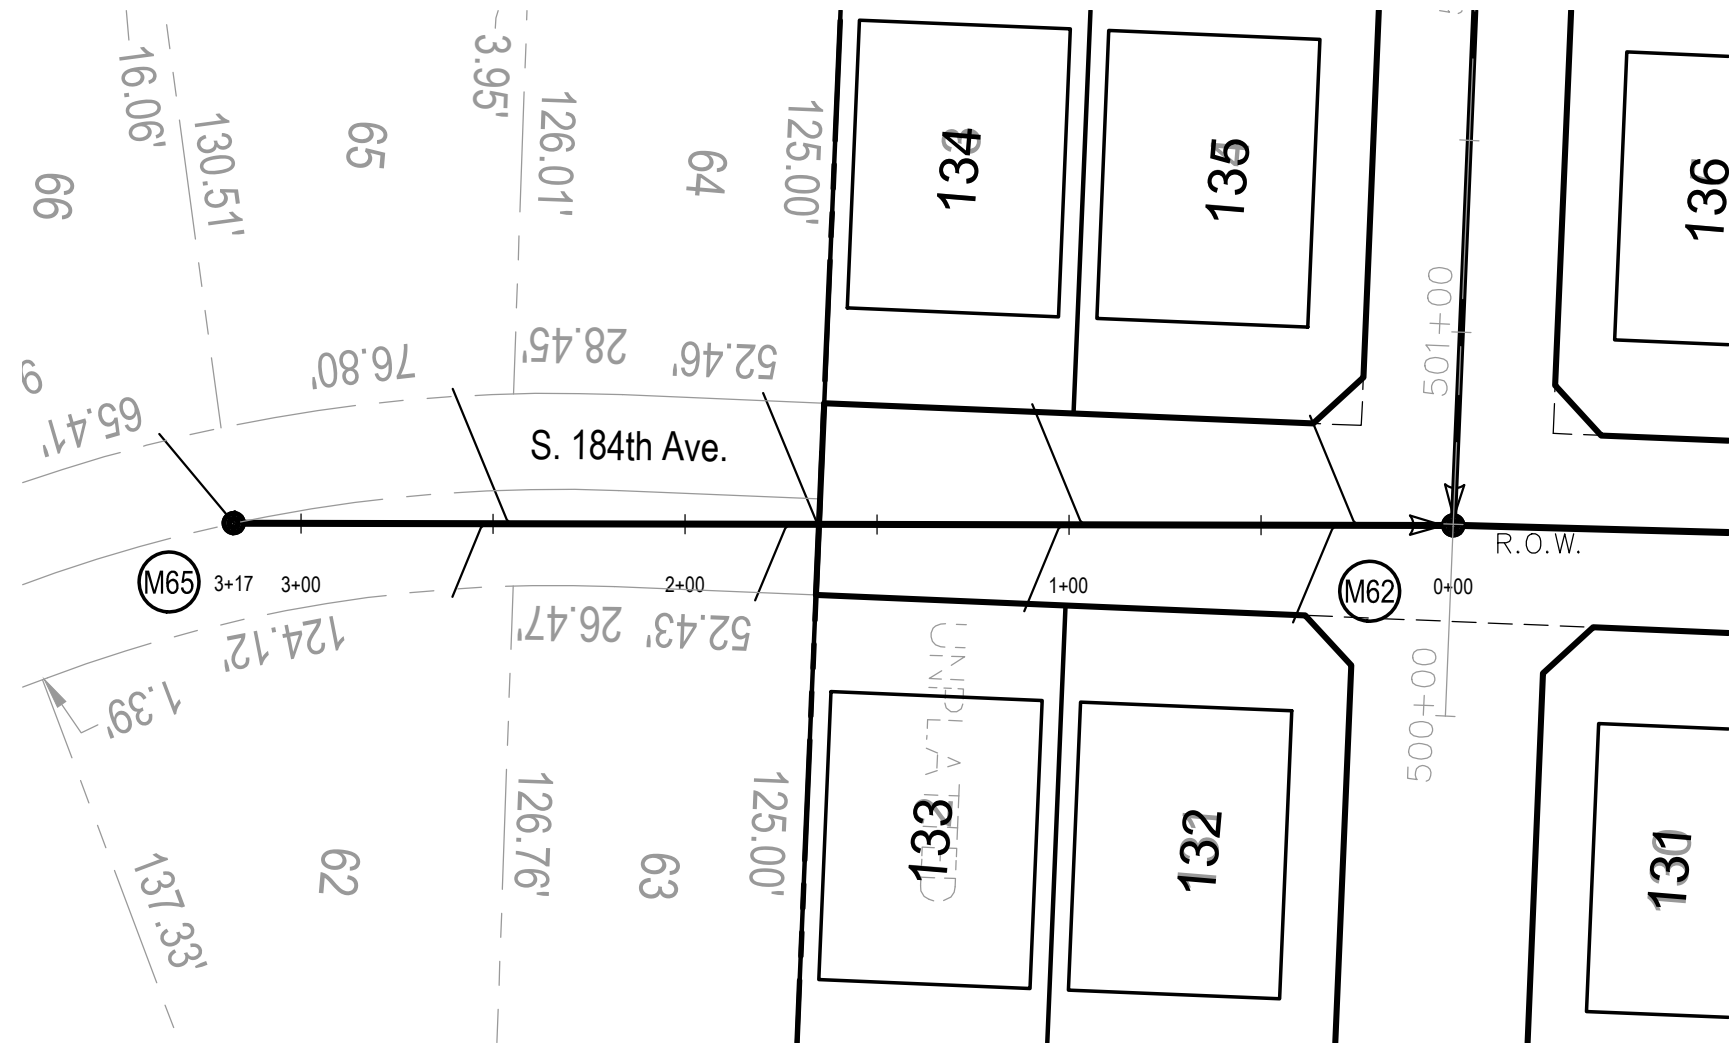

RECORD DRAWINGS

THESE PLANS HAVE BEEN REVISED TO CONFORM TO CONSTRUCTION RECORDS



REVISION DATE: 6/19/2018 BY: HLB

CHECKED BY: *RP*

CONTRACTOR: Kersten Construction, Inc.

E & A CONSULTING GROUP, INC.

Scale: Horiz. 1"=50'
Vert. 1"=5'

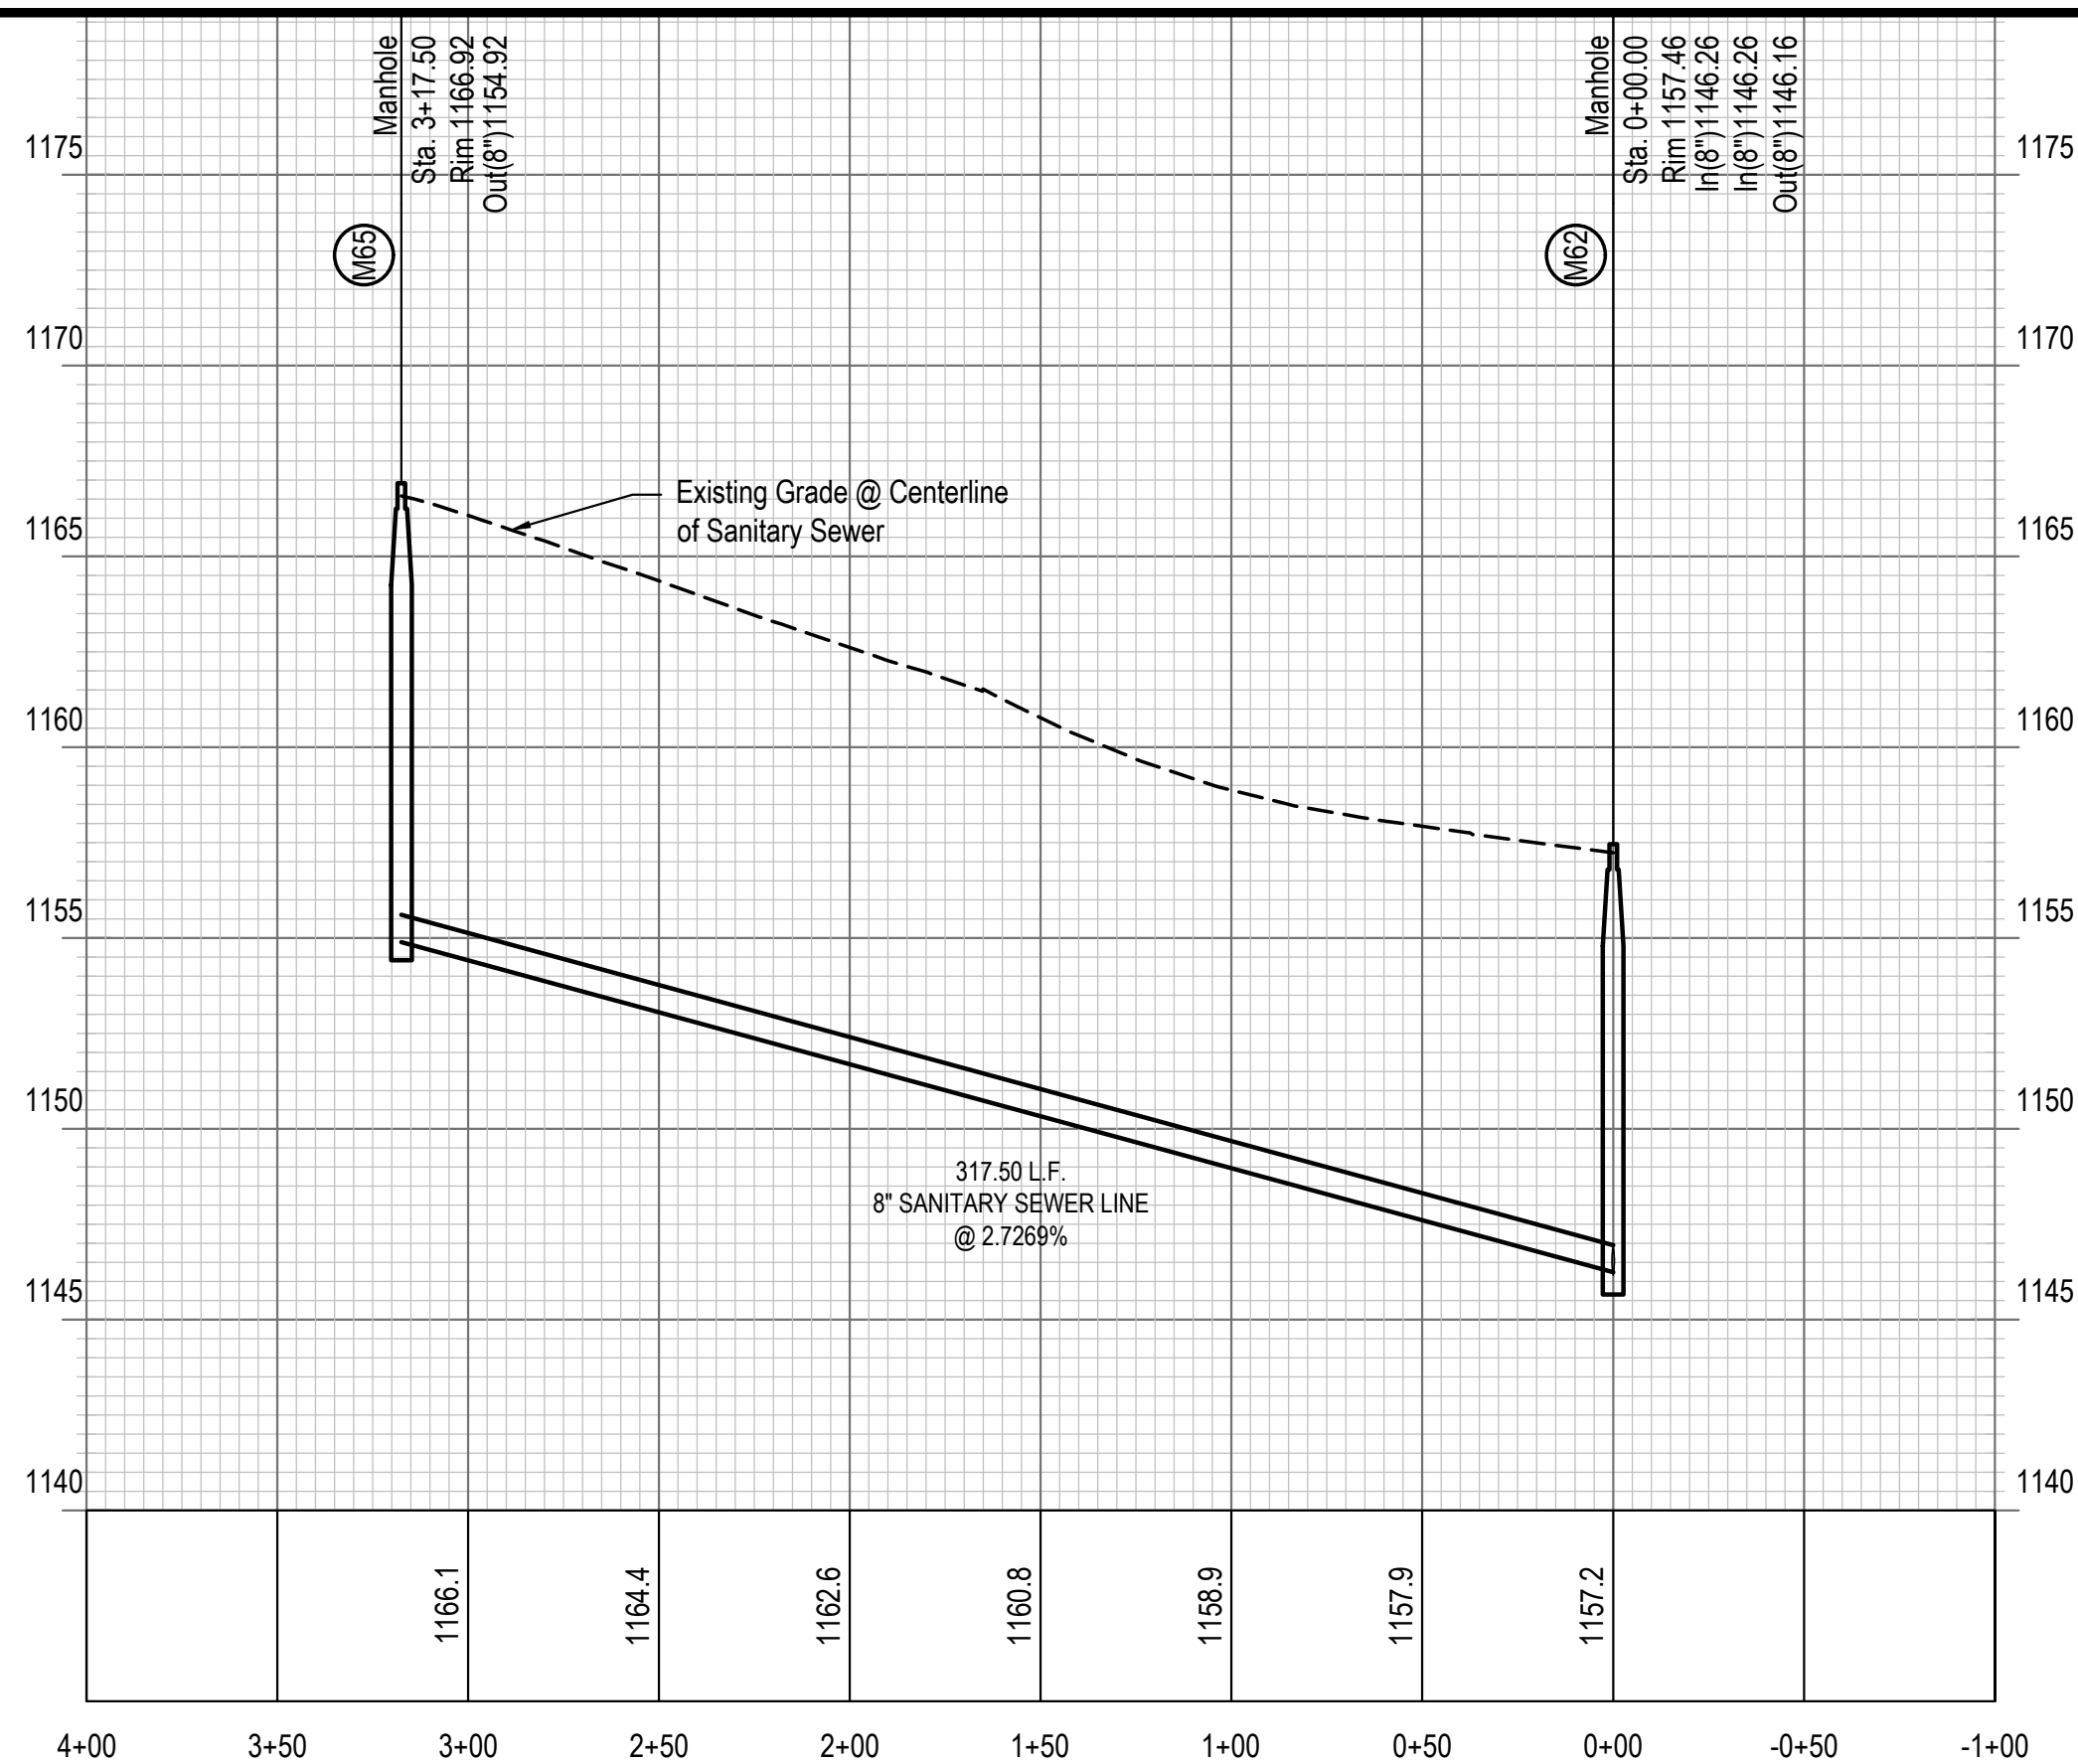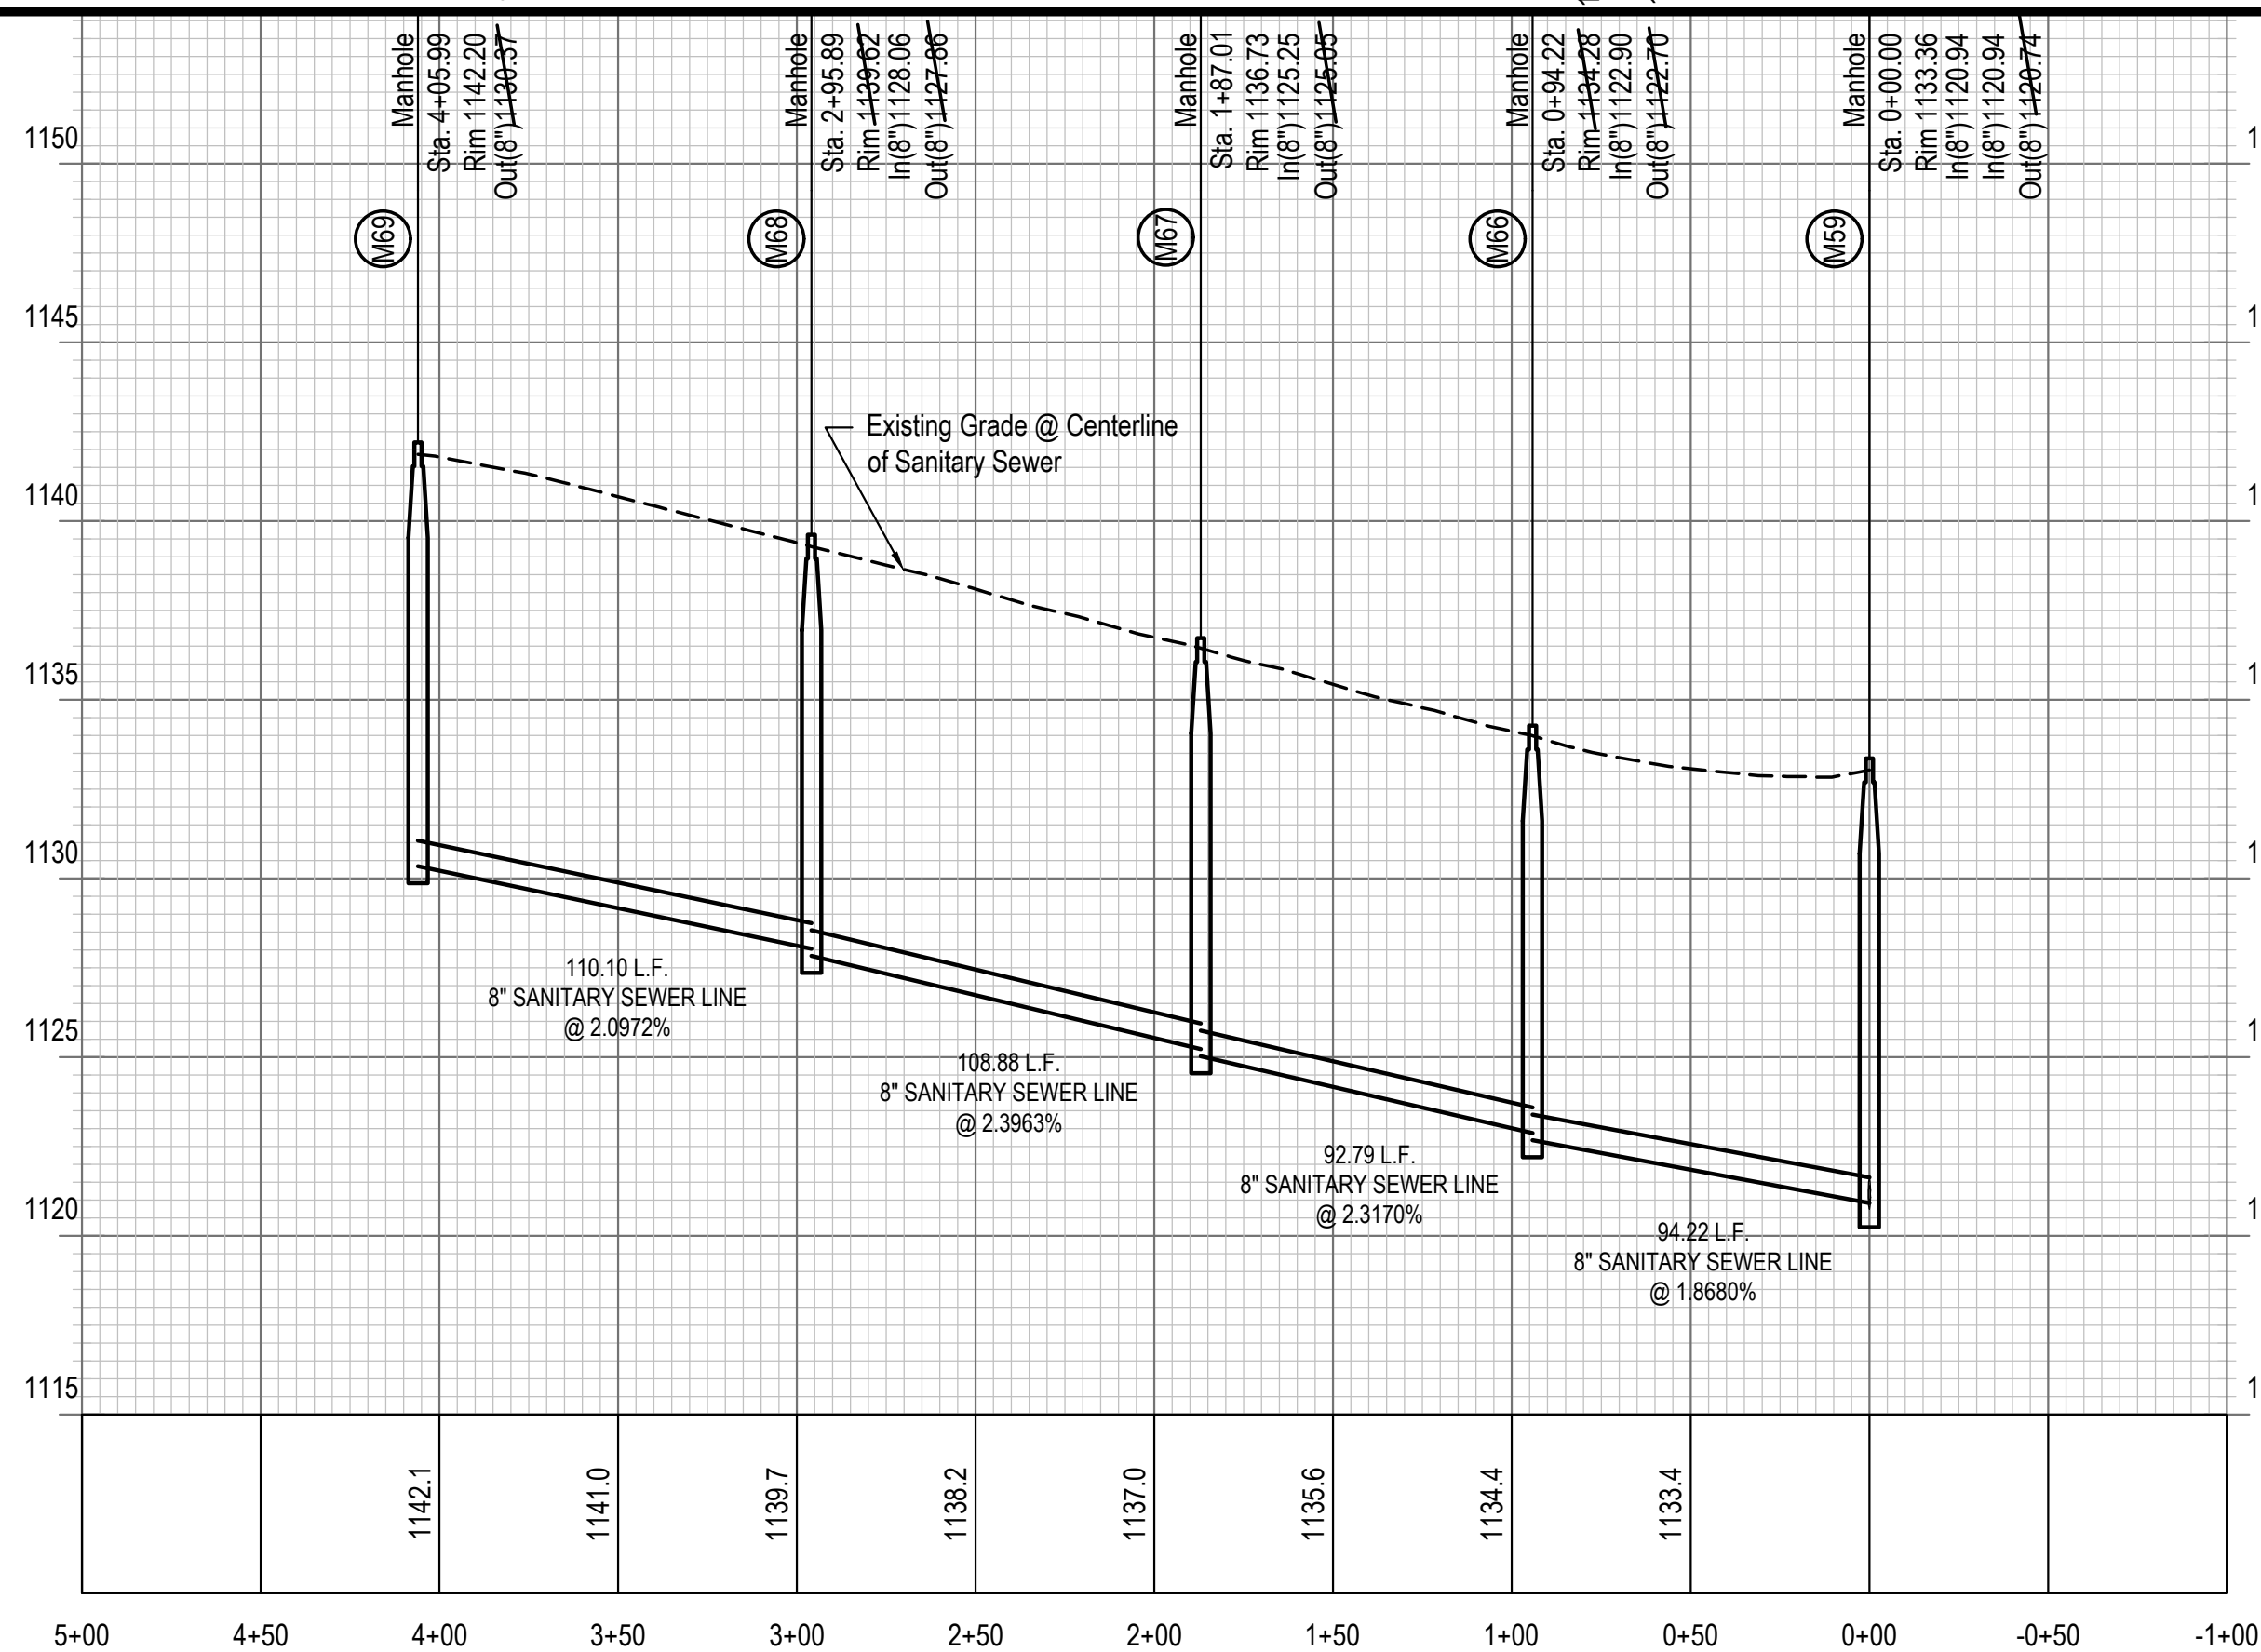

E & A CONSULTING GROUP, INC.
Engineering • Planning • Environmental & Field Services



GARDEN OAKS
LOTS 1 THRU 147 INCLUSIVE &
OUTLOTS "A" THRU "D"
SARPY COUNTY, NEBRASKA

BLACKWALNUT ST & S
184TH AVE (RIVER OAKS)
SS PLAN & PROFILE



Revisions		Date	
No.	Description		
0	As Built	6/19/2018	
1	Design	10/20/2016	JLW
2	Drawn By		JUN
3	Scale		SEE PLAN
4	Sheet		17 of 17